RECEIVED
AUG 27 1981
WATER RESOURCES DEPT
SALEM, OREGON

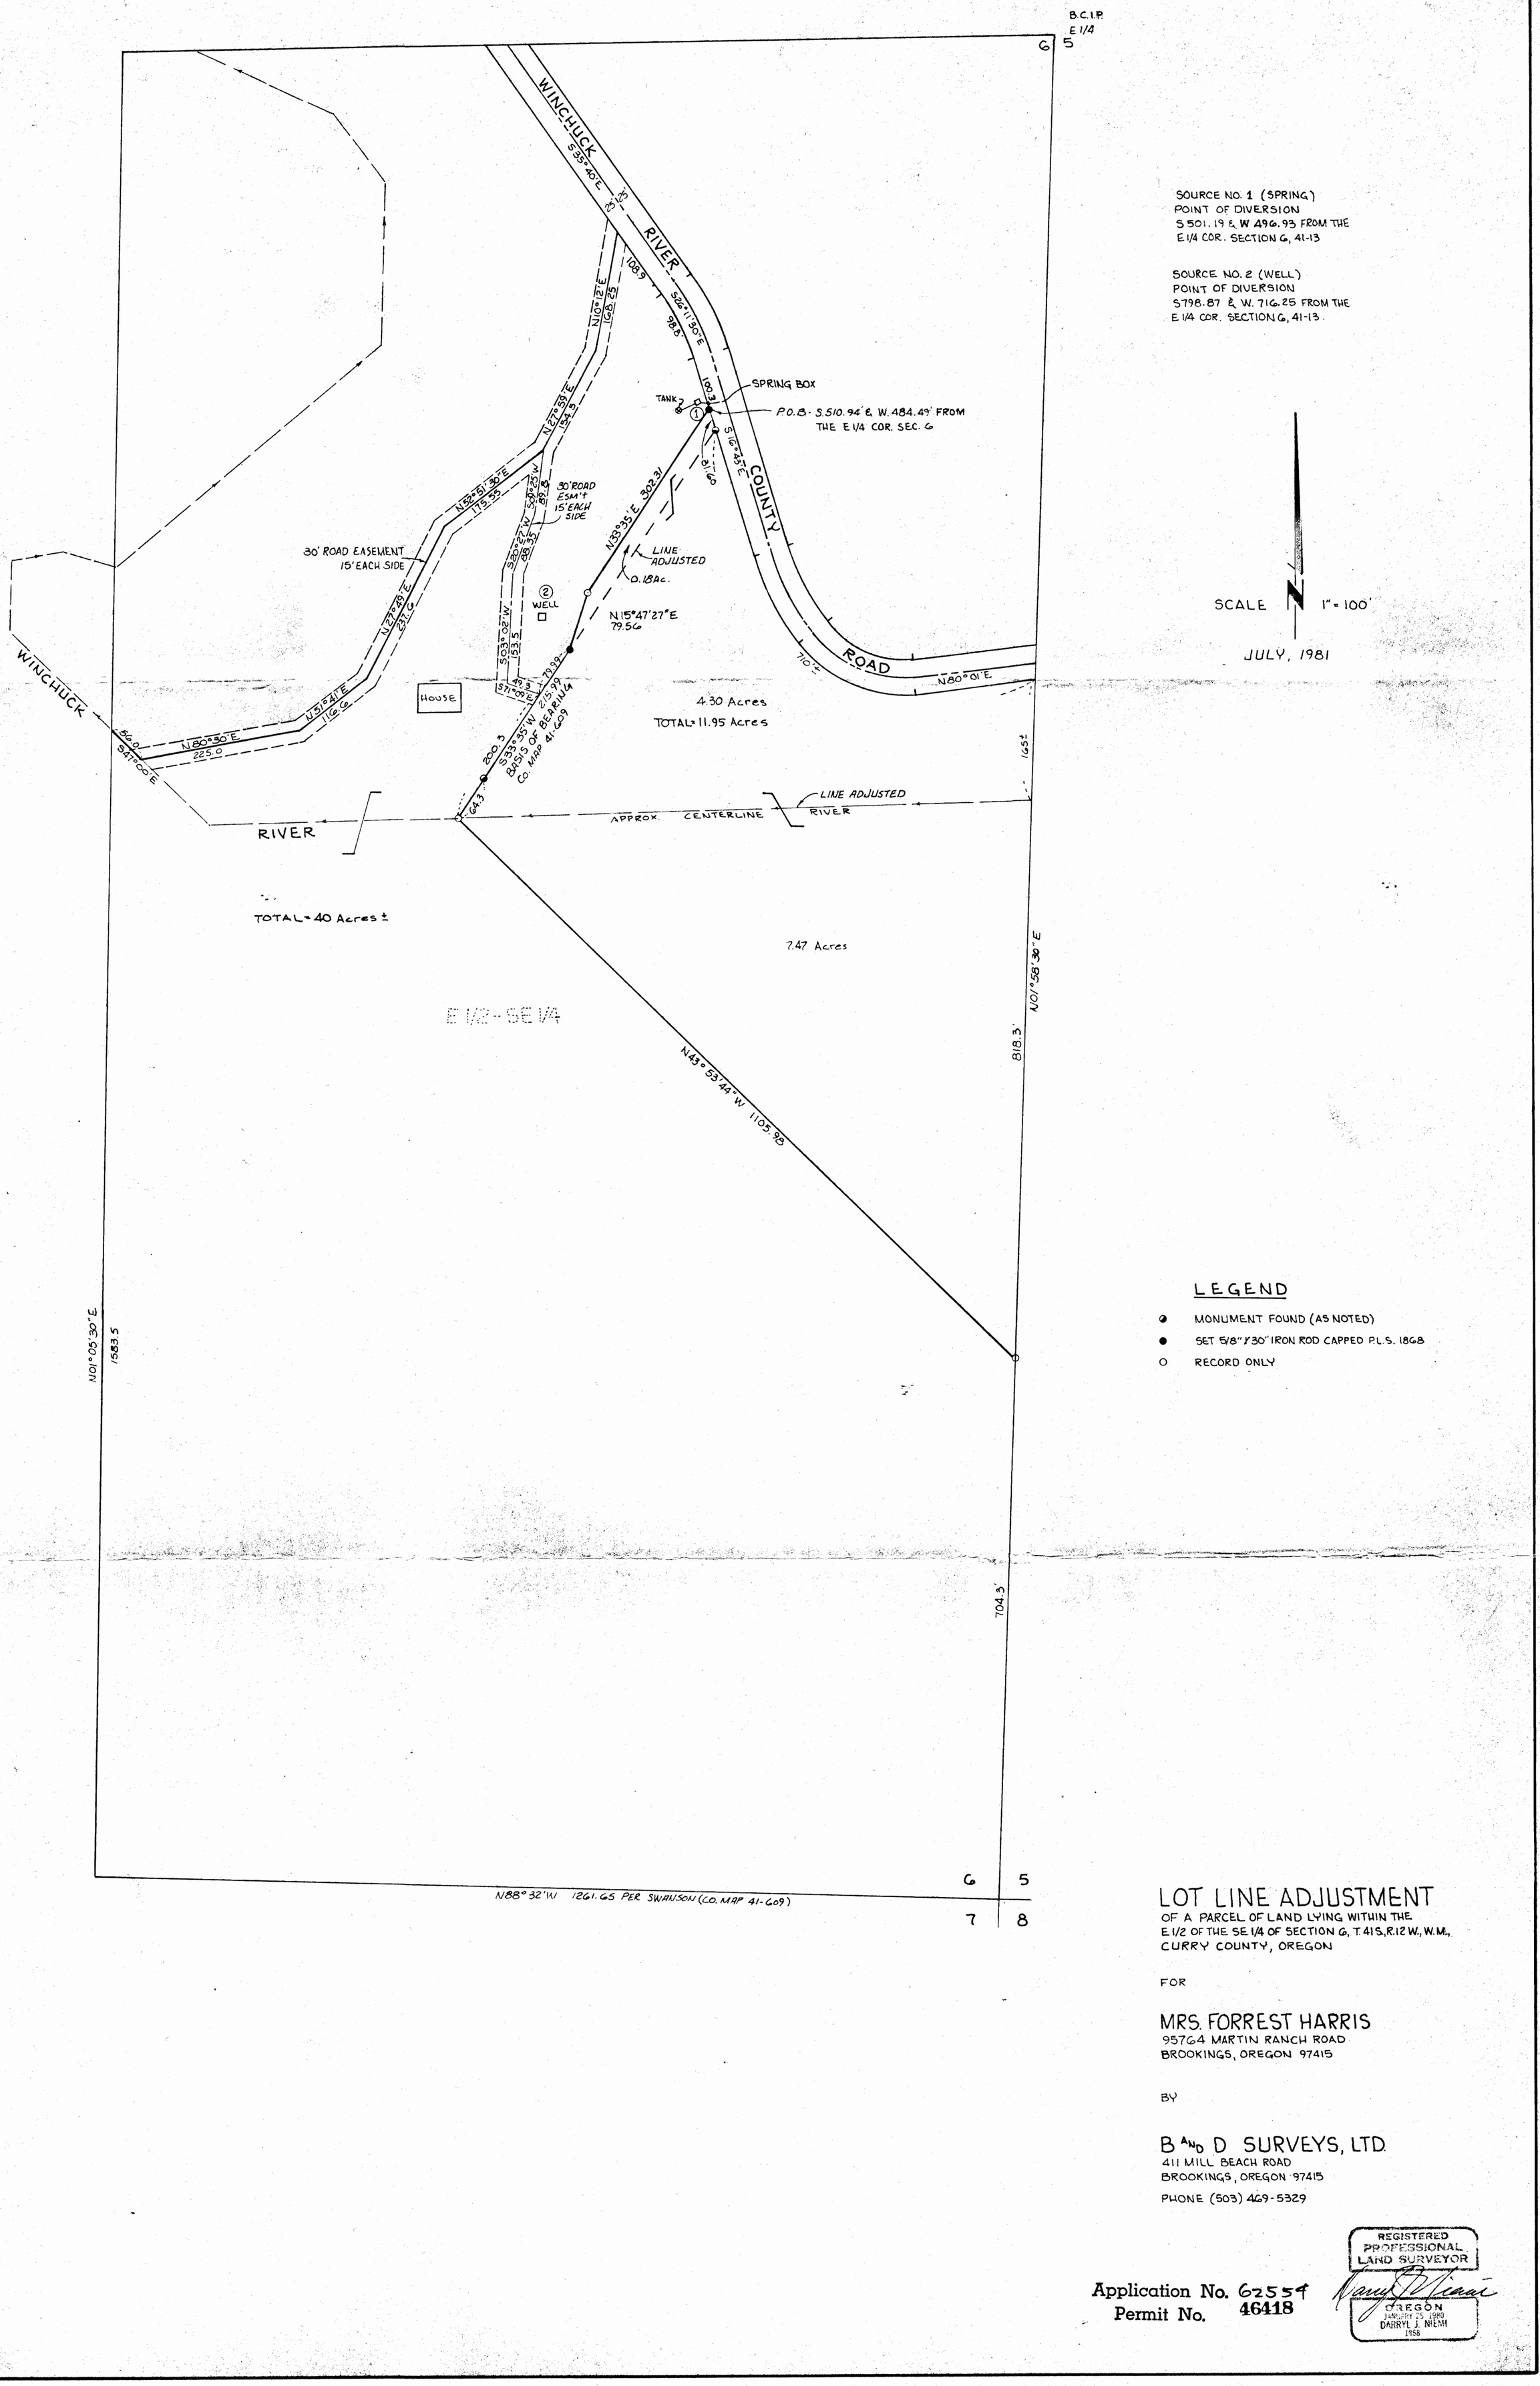

SOURCE NO. 1 (SPRING)
POINT OF DIVERSION
S 501.19 & W 496.93 FROM THE
E 1/4 COR. SECTION 6, 41-13

SOURCE NO. 2 (WELL)
POINT OF DIVERSION
S 798.87 & W. 716.25 FROM THE
E 1/4 COR. SECTION 6, 41-13.

SCALE 1" = 100'

JULY, 1981

LEGEND

- ◒ MONUMENT FOUND (AS NOTED)
- ● SET 5/8" X 30" IRON ROD CAPPED P.L.S. 1868
- ○ RECORD ONLY

LOT LINE ADJUSTMENT

OF A PARCEL OF LAND LYING WITHIN THE
E 1/2 OF THE SE 1/4 OF SECTION 6, T. 41S., R. 12 W., W.M.,
CURRY COUNTY, OREGON

FOR

MRS. FORREST HARRIS
95764 MARTIN RANCH ROAD
BROOKINGS, OREGON 97415

BY

B AND D SURVEYS, LTD.
411 MILL BEACH ROAD
BROOKINGS, OREGON 97415
PHONE (503) 469-5329

REGISTERED PROFESSIONAL LAND SURVEYOR
OREGON
JANUARY 15, 1980
DARRYL J. NIEMI
1958

Application No. 62554
Permit No. 46418