


T. 23S., R. 7W., W.M.

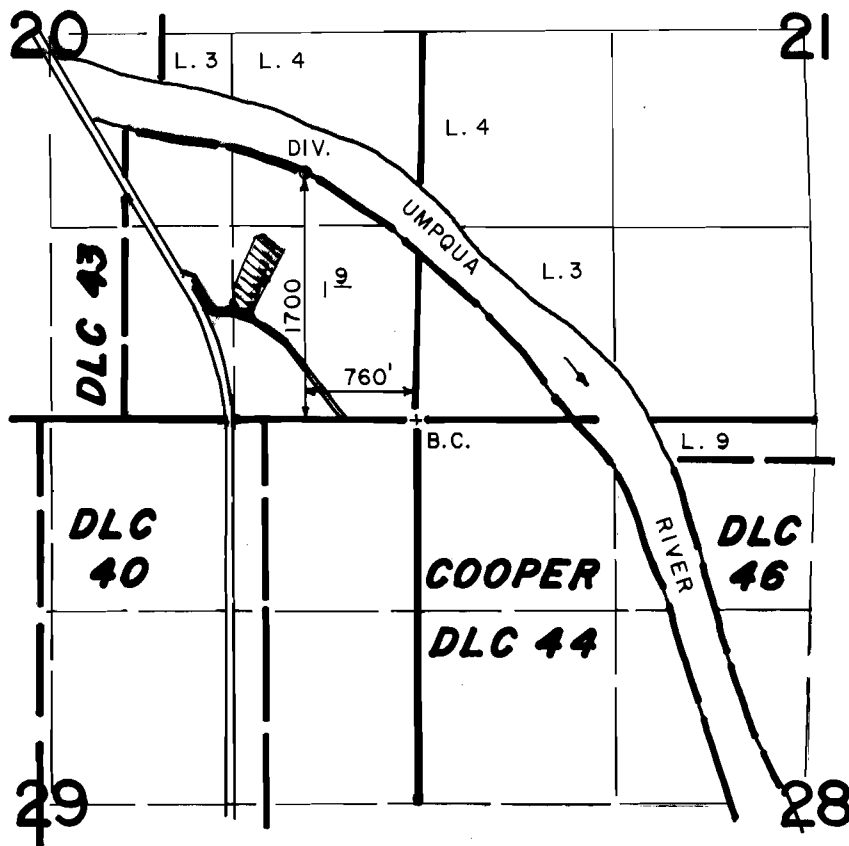

SCALE: 4" = 1 MILE

FINAL PROOF SURVEY
UNDER

Application No. 62962... Permit No. 46766.....
IN NAME OF

THE ESTATE OF ANNA J. TOTH

Surveyed AUG. 12... 1987., by J.M. SCHMORDE