


T. 1N., R. 4W., W.M.

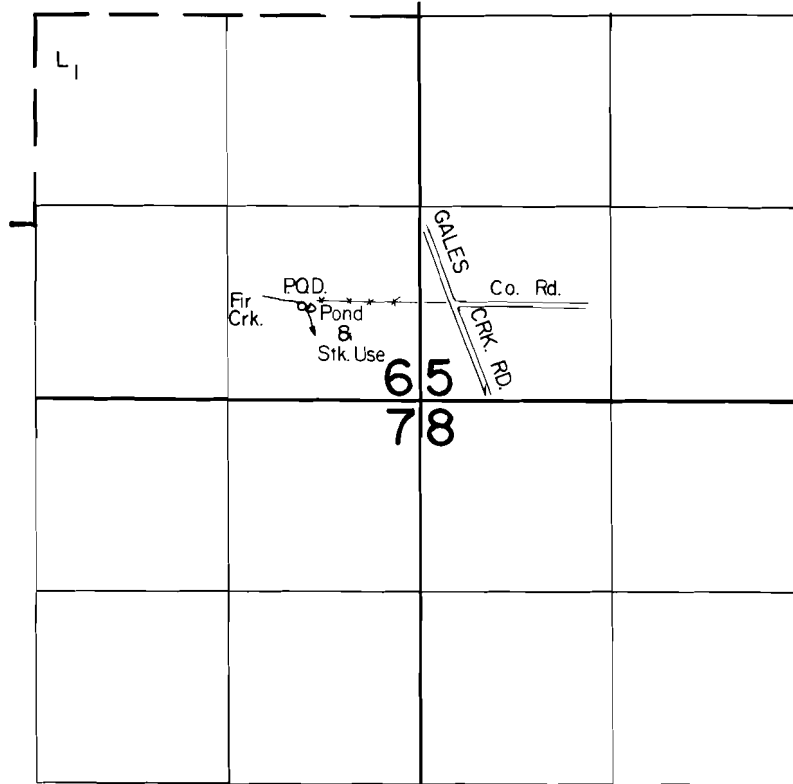

P.O.D. Loc. : 650' N. & 800' W. from SE Cor. Sec. 6.

Scale : 1" = 1320'

FINAL PROOF SURVEY UNDER

R-62967 R-8442
Application No. 62968 Permit No. 46767

IN NAME OF

MARVIN H. & JOYCE E. MACE

Surveyed JULY 28 1988, by T. Warren

41067-178-92B
11/17/88 TAW