


T. 2 N., R. 4 W., W.M.

N

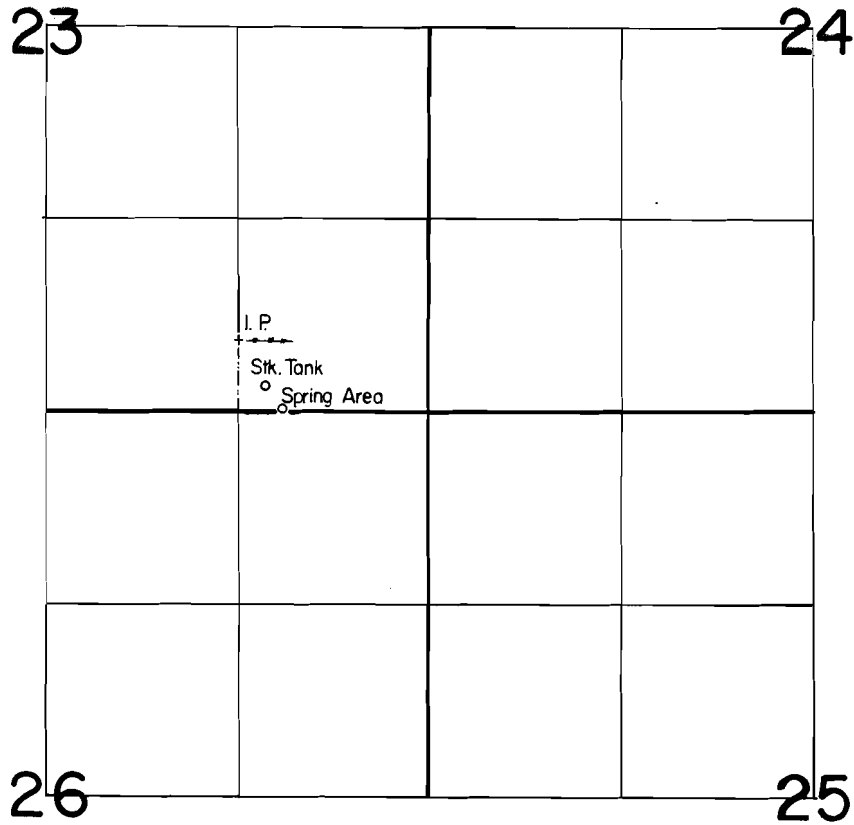

Spring Loc. : 1000' W. from SE Cor. Sec. 23

Scale : 1" = 1320'

FINAL PROOF SURVEY UNDER

Application No. 63037 Permit No. 47199.....

IN NAME OF

DOUGLAS H. HAHN

Surveyed May 20 1987, by Ben Bishop.....