


T3N, R9W, WM

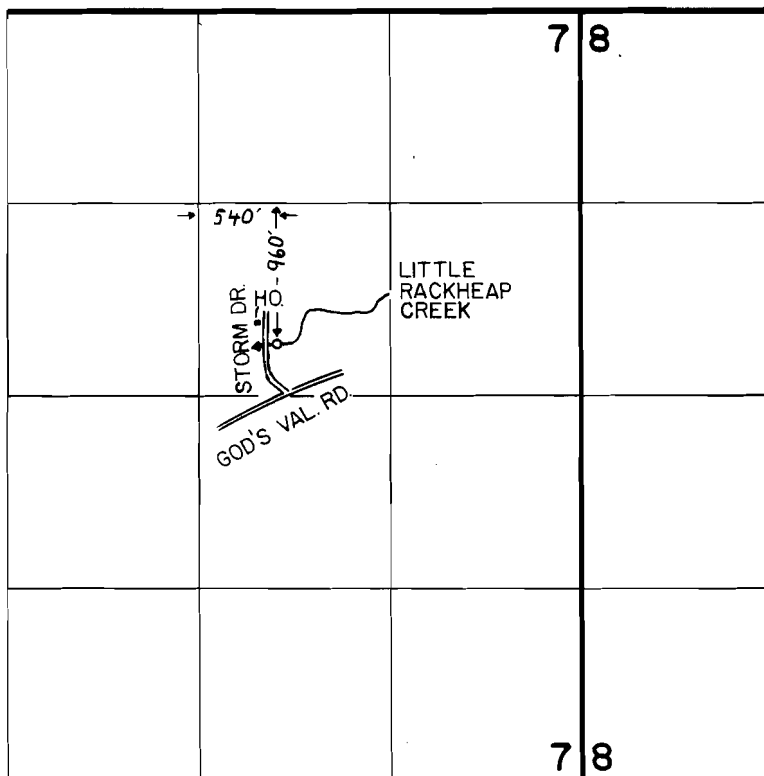

FINAL PROOF SURVEY

UNDER

Application No. .63067... Permit No. .46652.....
IN NAME OF

ALBERT L. NIDA

Surveyed JULY 7, 1987, by T.M. WARREN