

Application No. R-63212 & 63213

Permit No. R 8465 46848


725 R3E

RECEIVED

JAN 13 1982

WATER RESOURCES DEPT.
SALEM, OREGON

SECTION 11

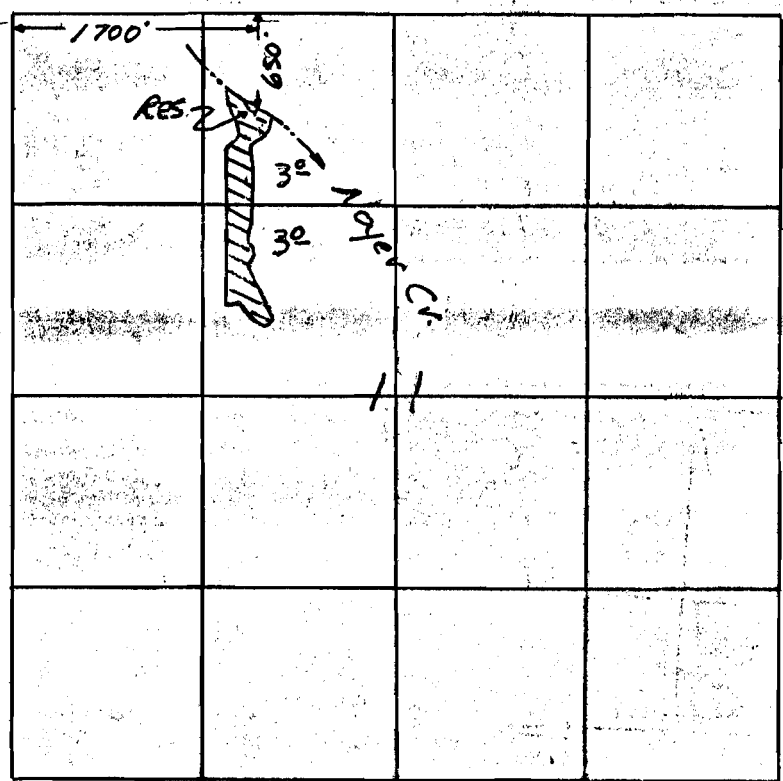

Scale 4" = 1 mile