


T. 2S. R. 3E. W. M.

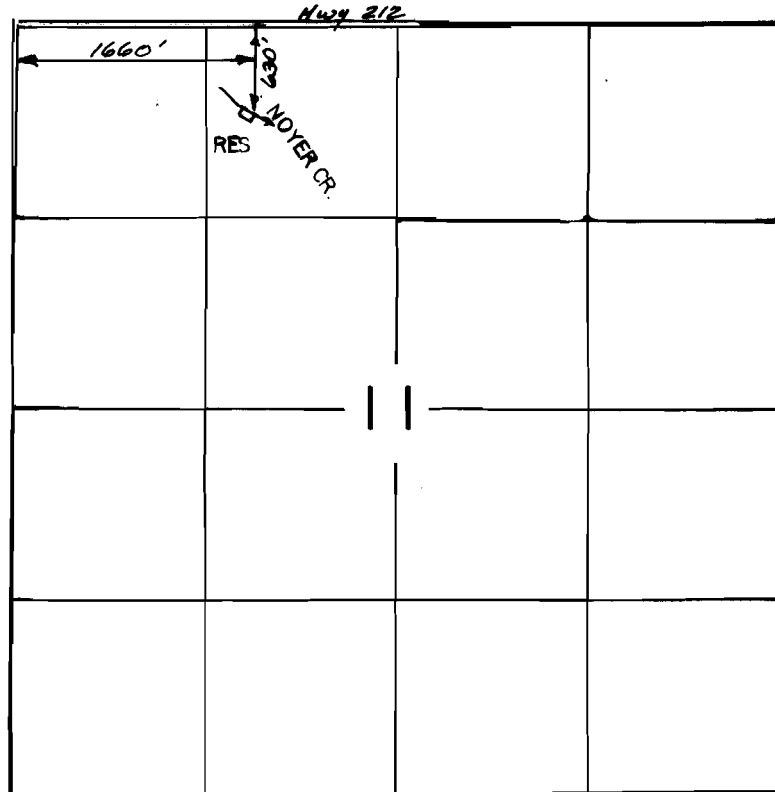

SCALE: 1" = 1320

FINAL PROOF SURVEY
UNDER

R-63212 R-8465
Application No. ~~6.3213~~ Permit No. ~~46848~~
IN NAME OF

LARRY W. & SHIRLEY J. GUNTER

Surveyed JUNE 5 1987, by T. M. WARREN