


# T. 9S., R. 27E., W.M.

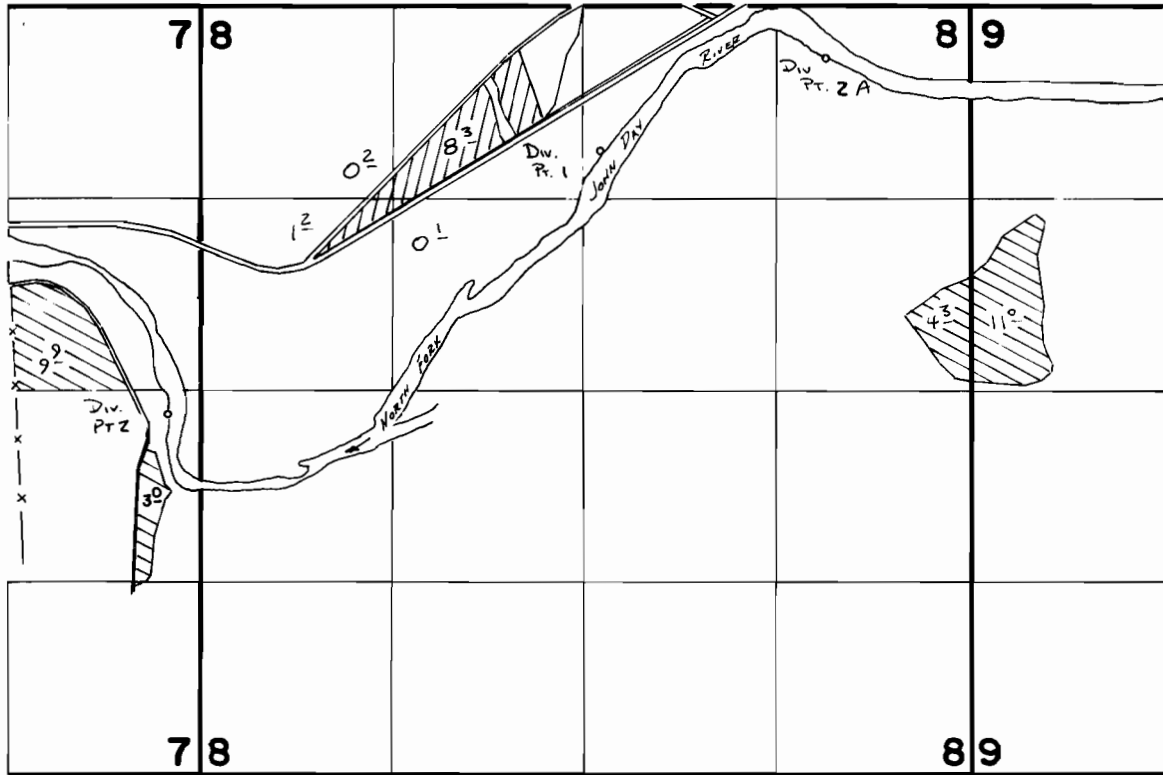

DIV. PT. 2 LOCATED 170' S. & 230' W. FROM E 1/4 COR. SEC. 7  
 DIV. PT. 1 LOCATED 1000' S. & 120' E. FROM N 1/4 COR. SEC. 8  
 DIV. PT. 2A LOCATED 350' S. & 1670' E. FROM N 1/4 COR. SEC. 8



WESTERN



SILVA

## FINAL PROOF SURVEY UNDER

Application No. **63503** Permit No. **46922...**

IN NAME OF

**FRANK & MANUEL SILVA**

WESTERN RIDGE LAND COMPANY

Surveyed 9-4-1985, by W.L. Church

SCALE: 1" = 1320'