


T.2S. R.4E. W.M.

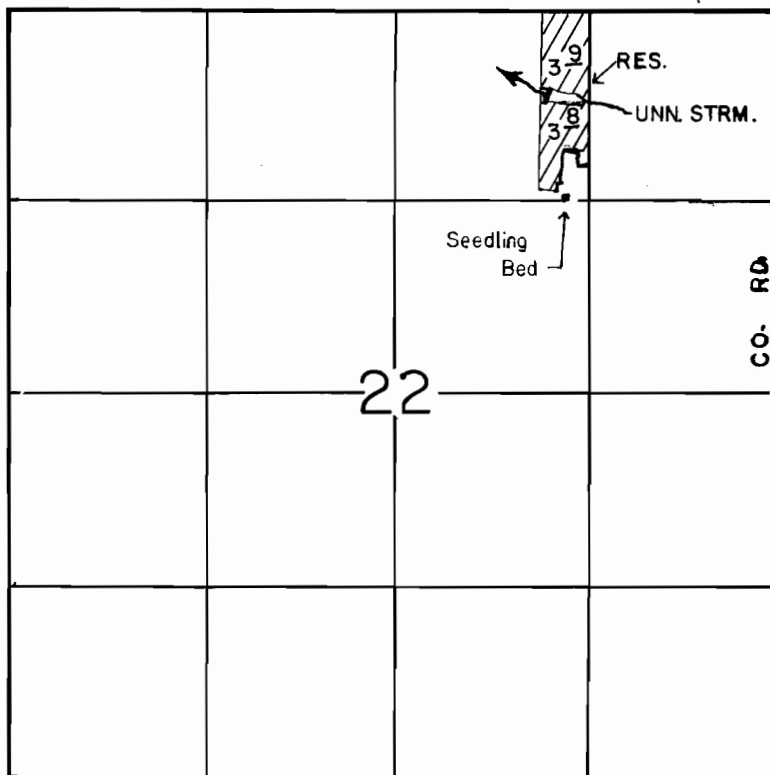

RES. LOC. 550' S. AND 1600' W. FROM THE N.E. COR. OF SEC. 22

SCALE: 1" = 1320'

FINAL PROOF SURVEY UNDER

R-63976 R-8506
Application No. 63977 Permit No. 47064
IN NAME OF

LAWRENCE D. TERRILL

Surveyed AUG. 25 1987, by J.M. WARREN