


T. 37 S., R. 3 W., W.M.

POOL IN CREEK  
5/8" LINE.

55 DRUM ROLLER  
SEDIMENT TANK.

U.S. Govt.

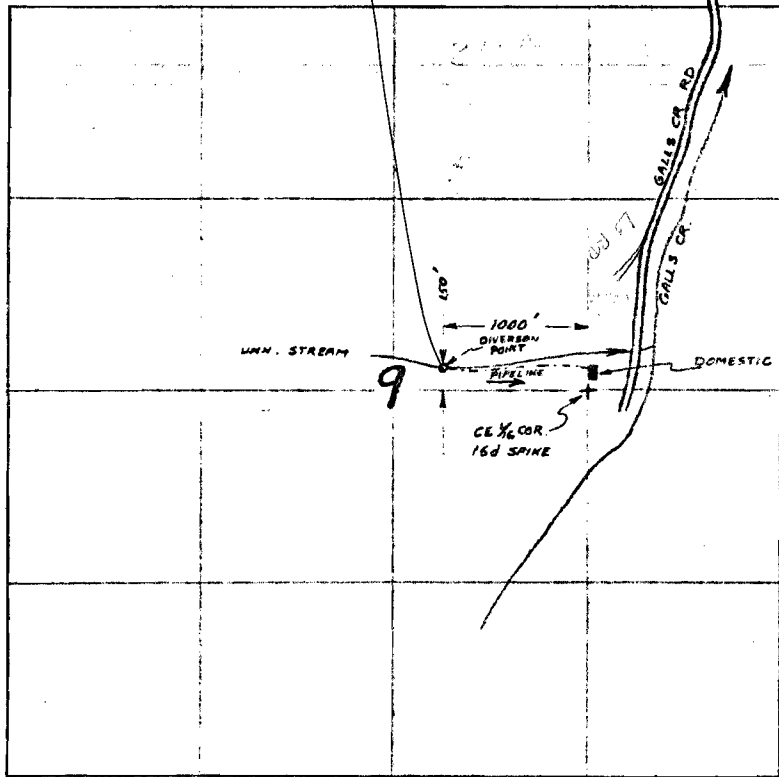

WINTER,  
EARLY SPRING  
DRILLED WELL  
1953m.

50751

SCALE: 4" = 1 MILE

DIV. P. LOC.: 150' NORTH AND 1000' WEST FROM THE SW COR. OF THE SE 1/4 OF THE NE 1/4 OF SEC. 9, T. 37 S., R. 3 W., W.M. BEING WITHIN SW 1/4 OF NE 1/4

MAP TO ACCOMPANY APPLICATION OF MIKE MARTIN TO APPROPRIATE WATER FROM UNNAMED STREAM FOR DOMESTIC PURPOSES.

Application No. 64623

Permit No. 47501

RECEIVED

FEB 25 1983

WATER RESOURCES DEPT.  
SALEM, OREGON

1/2 m  
PN ID

