


T. 1 & 2 N., R. 14 E., W.M.

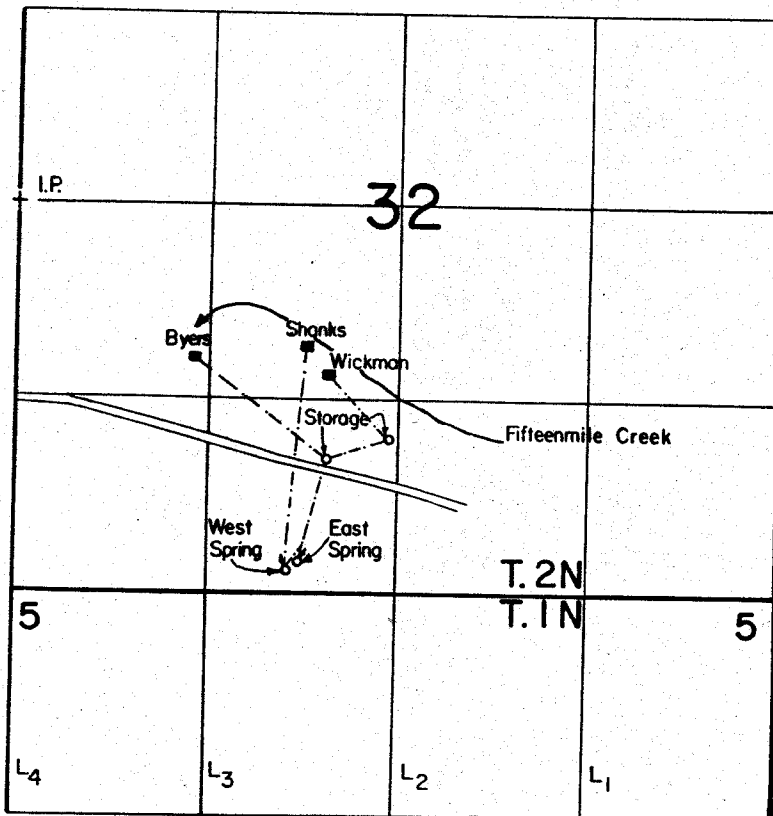

West Spring Loc. : 2480' S. & 1900' E.
East Spring Loc. : 2430' S. & 1960' E., both from W. 1/4 Cor., Sec. 32.

Scale : 1" = 1320'

FINAL PROOF SURVEY
UNDER

Application No. 64839 Permit No. 47551

IN NAME OF
GENE & BARBARA BYERS, WILLIS J. & ROSEMARY SHANK,
& HARRY L. & MYRTLE P. WICKMAN

Surveyed April 13, 1988., by T. Warren

41065-179-124 B
10/17/88 TMW