


T. 3 S. R. 2 E. W. M.

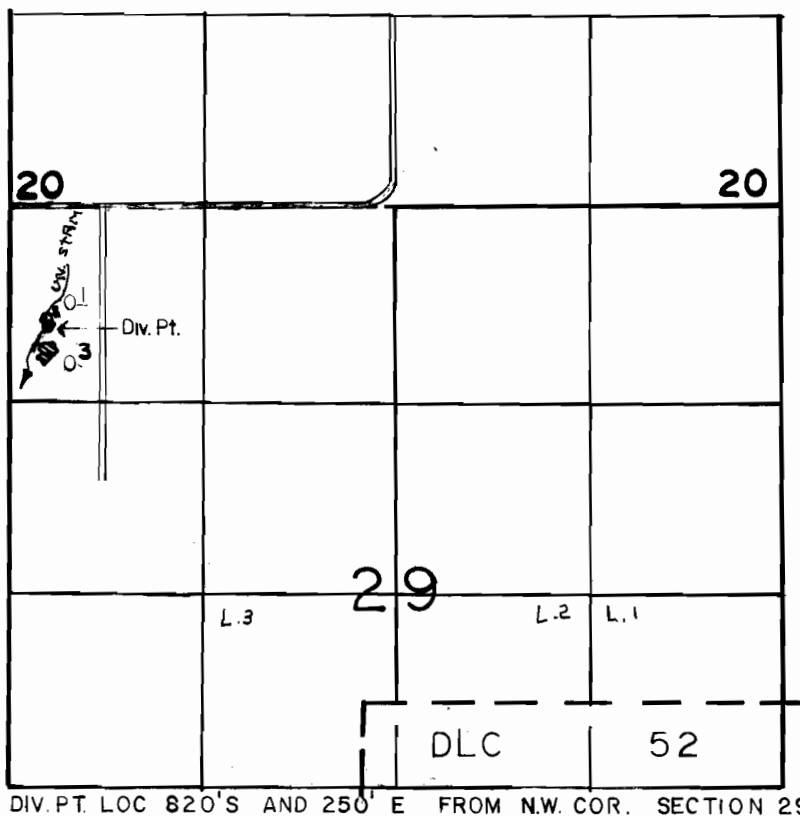

DIV. PT. LOC 820'S AND 250' E FROM N.W. COR. SECTION 29

SCALE: 1" = 1320'

FINAL PROOF SURVEY UNDER

Application No. 64941 Permit No. 47489
IN NAME OF

JOHN W. & LINDA T. TAYLOR

Surveyed JULY 21, 1987, by T.M. WARREN