


Application No. 65016
Permit No. 47726

SW 1/4 SE 1/4

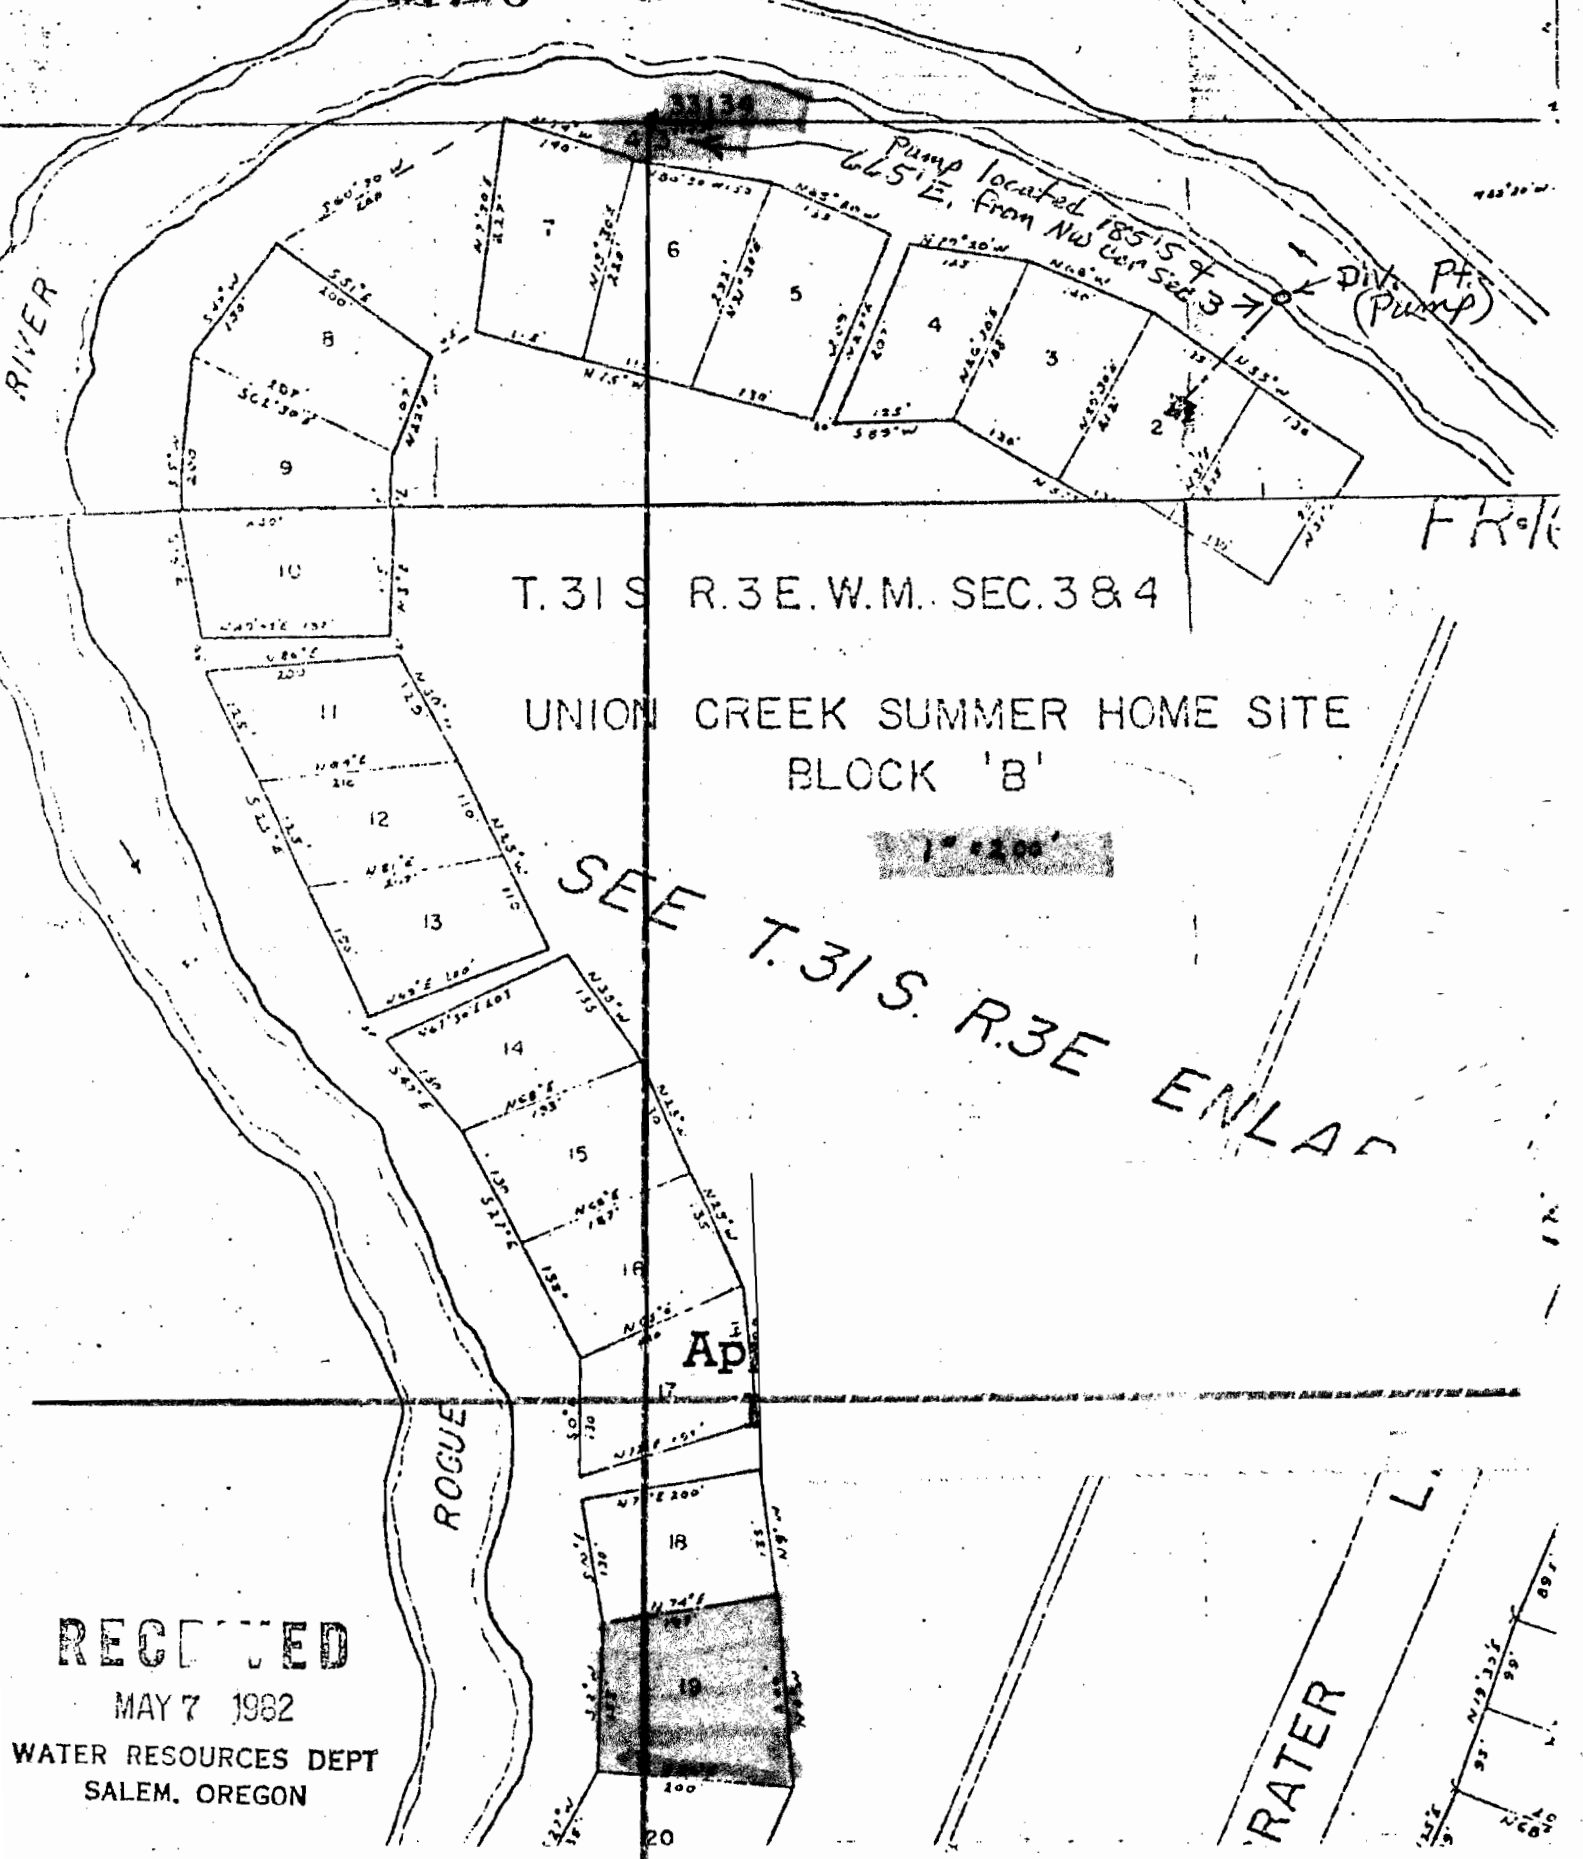

T. 31 S. R. 3 E. W.M. SEC. 3 & 4

UNION CREEK SUMMER HOME SITE
BLOCK 'B'

SEE T. 31 S. R. 3 E ENLAD

AP

RECEIVED
MAY 7 1982
WATER RESOURCES DEPT
SALEM, OREGON

