


**T5N, RIOW, WM
SEC 32**

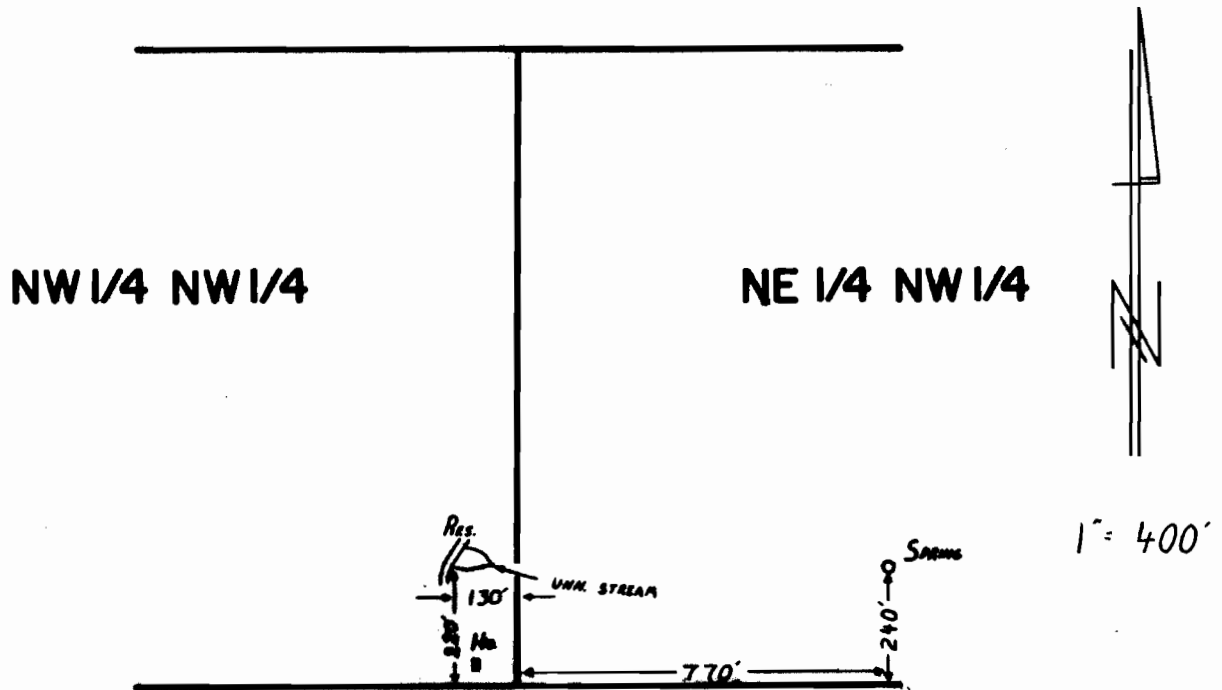

**FINAL PROOF SURVEY
UNDER**

R-65092 R-8889
Application No. 65092 Permit No. 47815
IN NAME OF

GARY D. MOON

Surveyed **AUG 15, 1988**, by **R.W. KLASSEN**

RWK
PTS w/r