


# T5N, R10W, WM SEC 32

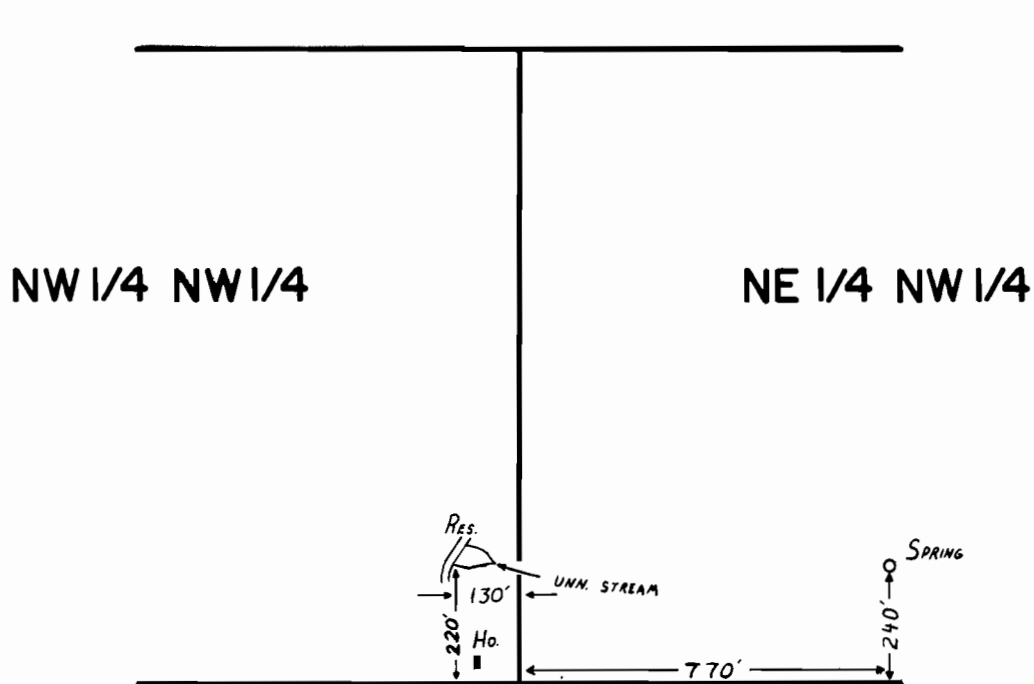

## FINAL PROOF SURVEY UNDER

Application No. R-65092 65093 Permit No. R-8889 47815  
IN NAME OF

GARY D. MOON

Surveyed AUG. 15, 1988, by R.W. KLASSEN