


T. 22 S., R. 5 & 6 W., W.M.

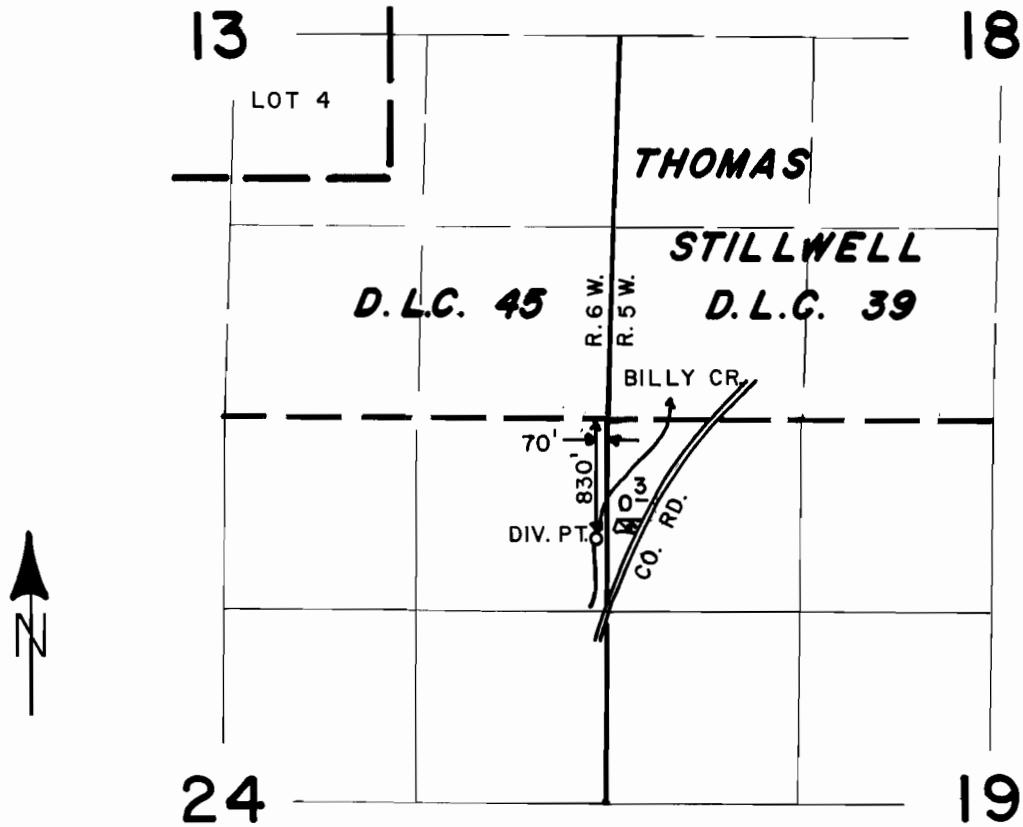

SCALE: 4" = 1 MILE

FINAL PROOF SURVEY
UNDER

Application No. 65279... Permit No. 47680.....
IN NAME OF

RODNEY JOSLYN AND A.V. TURNIDGE

Surveyed AUG. 4..... 1988., by J.M. SCHMORDE...