


T. 22 S., R. 6 W., W.M.

SECTION 13

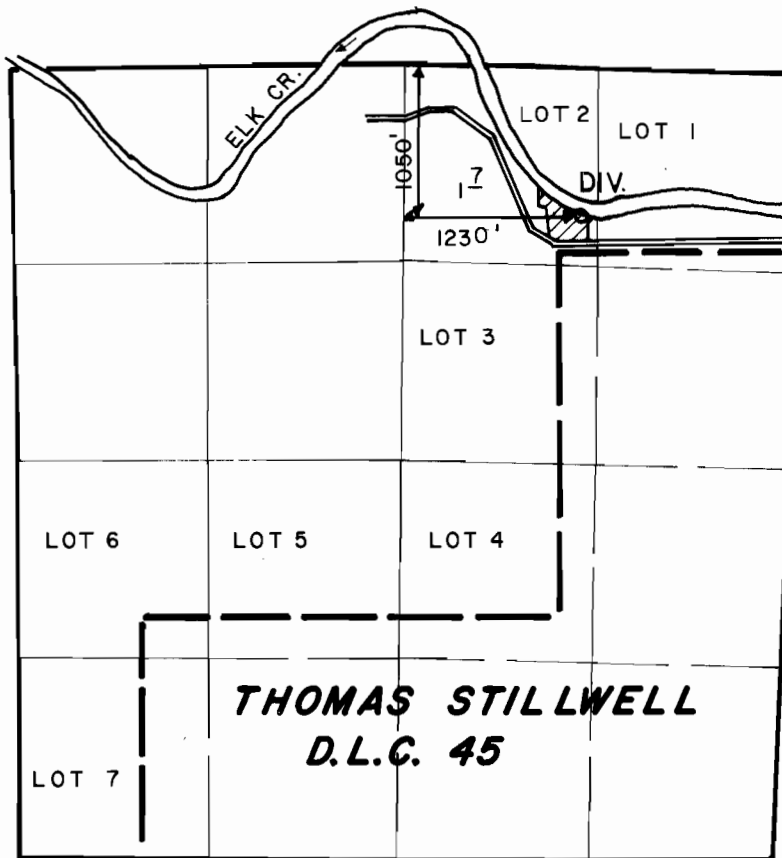

SCALE: 4" = 1 MILE

FINAL PROOF SURVEY UNDER

Application No. 65240 Permit No. 47883
IN NAME OF

Allan McDonald

Surveyed AUG. 4 1988, by J.M. SCHMORDE