


# T4N, R7W, WM

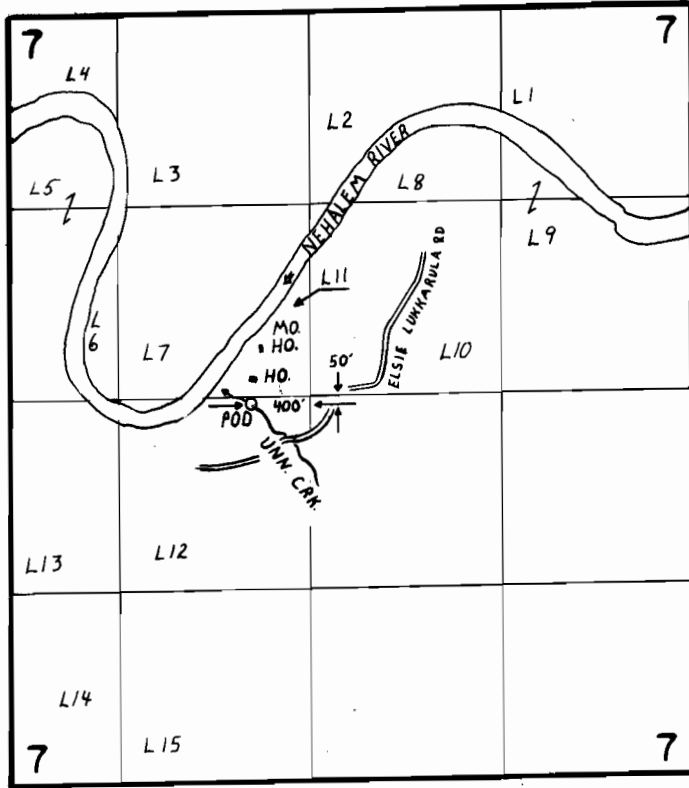

## FINAL PROOF SURVEY UNDER

Application No. .65335. Permit No. .48228.....  
IN NAME OF

.....WESLEY S. SHANER.....

Surveyed AUG. 17... 1988., by T.M. WARREN.....

RWK  
41007 280 37L