


T. 26 S., R. 3 W., W. M.

SECTIONS 2, 3, 10 and 11

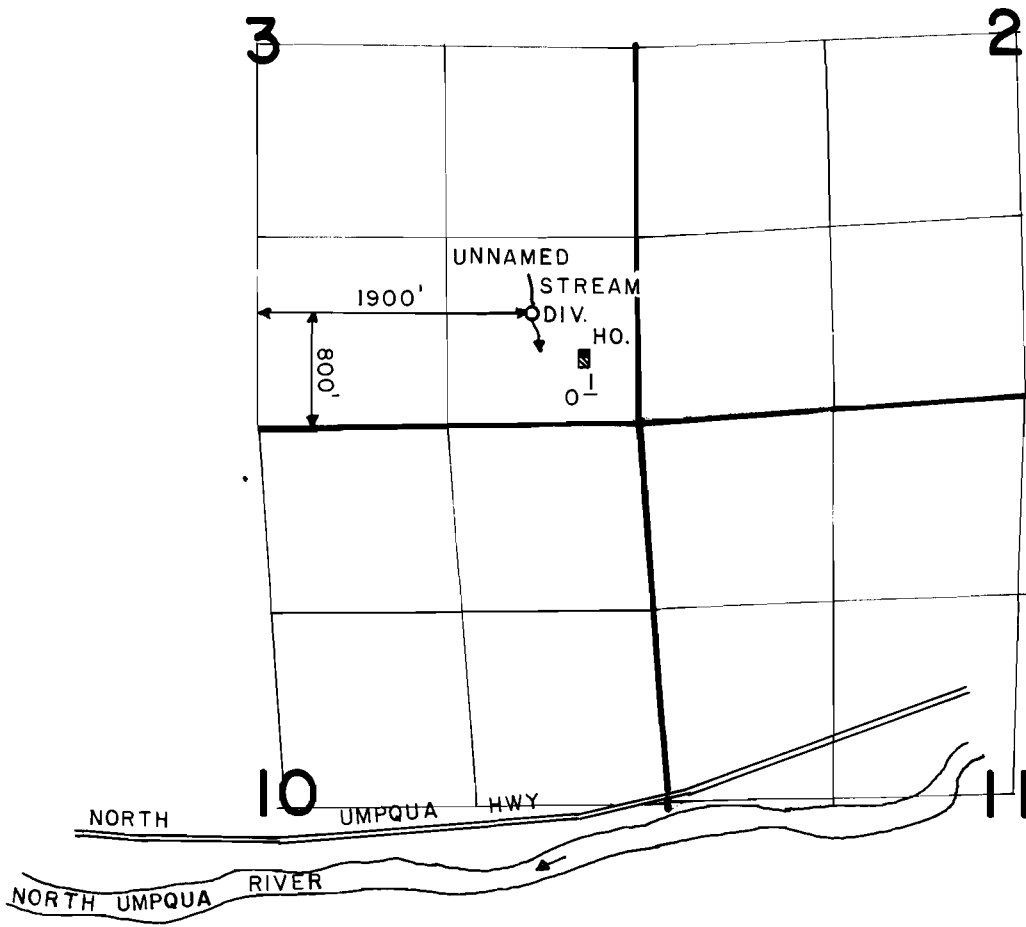

SCALE: 4" = 1 MILE

FINAL PROOF SURVEY UNDER

Application No. 65576 Permit No. 47997
IN NAME OF

DARYL S. ALOSA

Surveyed FEB. 12, 1988, by J. M. SCHMORDE