


T. 2 N., R. 5 W., W.M.

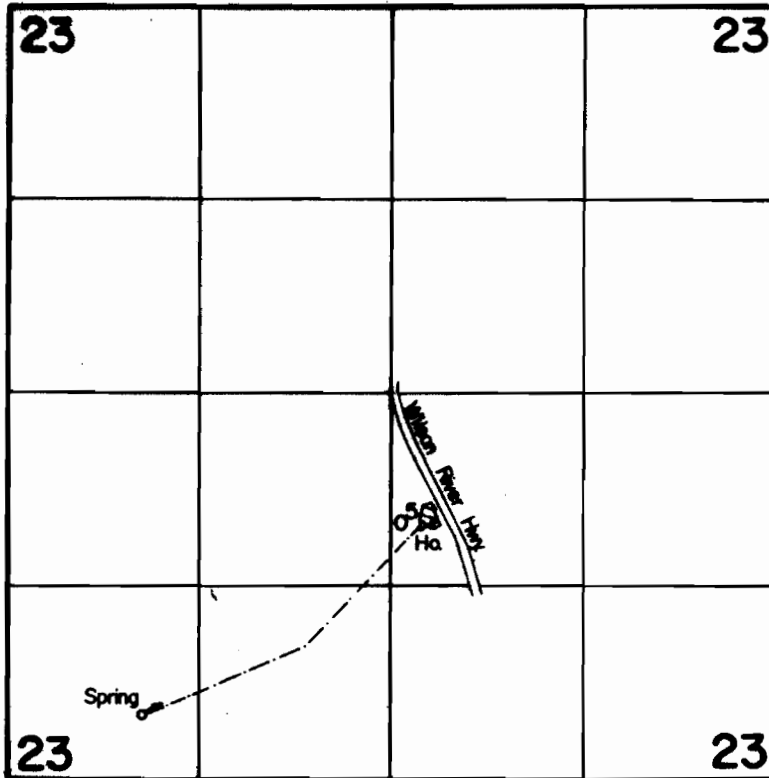

Spring Loc. : 450' N. & 930' E. from SW Cor. Sec. 23.

Scale : 1" = 1320'

FINAL PROOF SURVEY
UNDER

Application No. 68134 Permit No. 48754
IN NAME OF

WILLIAM HOWARD MARBLE

Surveyed May 20 1987, by Ben Bishop

Application No. 68134
Permit No. 48754

RECEIVED

JUL 20 1984
WATER RESOURCES DEPT.
SALEM, OREGON

SW 1/4 of SECTION 23 T2N R5W
WASHINGTON COUNTY, OREGON

SCALE 1" = 400'

