


T. 3 N., R. 3 W., W.M.

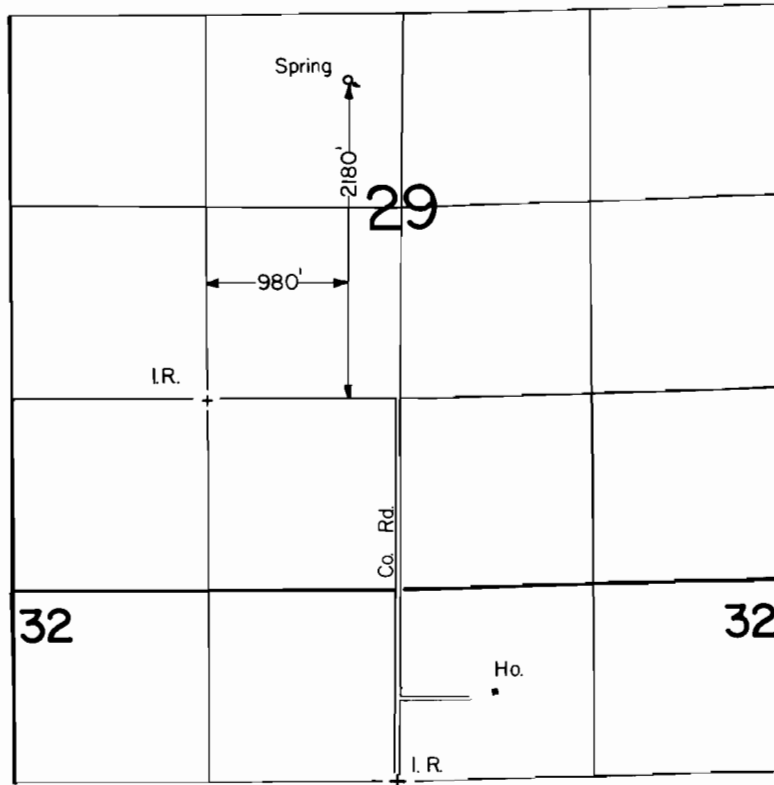

Scale: 1" = 1320'

FINAL PROOF SURVEY
UNDER

Application No. 68136 Permit No. 48756
IN NAME OF

ROBERT C. & BARBARA M. ALEXANDER

Surveyed Sept. 1 1988, by T. Warren

41067-278-207B
11/15/88 TMW