


# T. 10S., R. 4W., W.M.

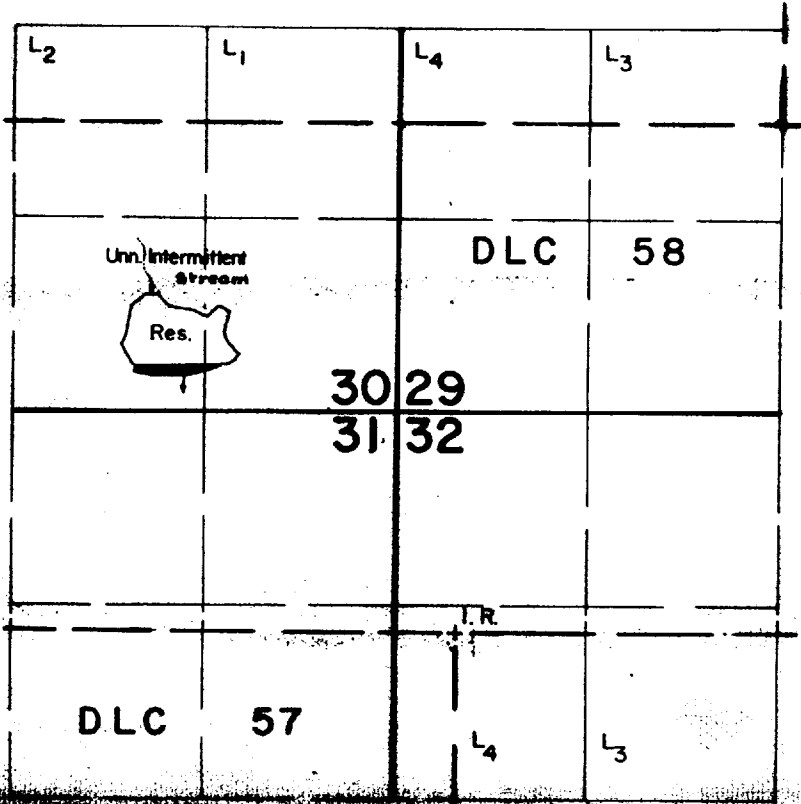

Dam Loc. : 1760' N. & 2000' W. from NE Cor. DLC 57.

Scale : 1" = 1320'

## FINAL PROOF SURVEY UNDER

R-68220                      R-10061  
Application No. 68221 Permit No. 49026  
IN NAME OF

OREGON DEPARTMENT OF FISH & WILDLIFE

Surveyed April 22, 1987, by T. Warren