


RECEIVED

JUL 1 1985

WATER RESOURCES DEPT
SALEM, OREGON

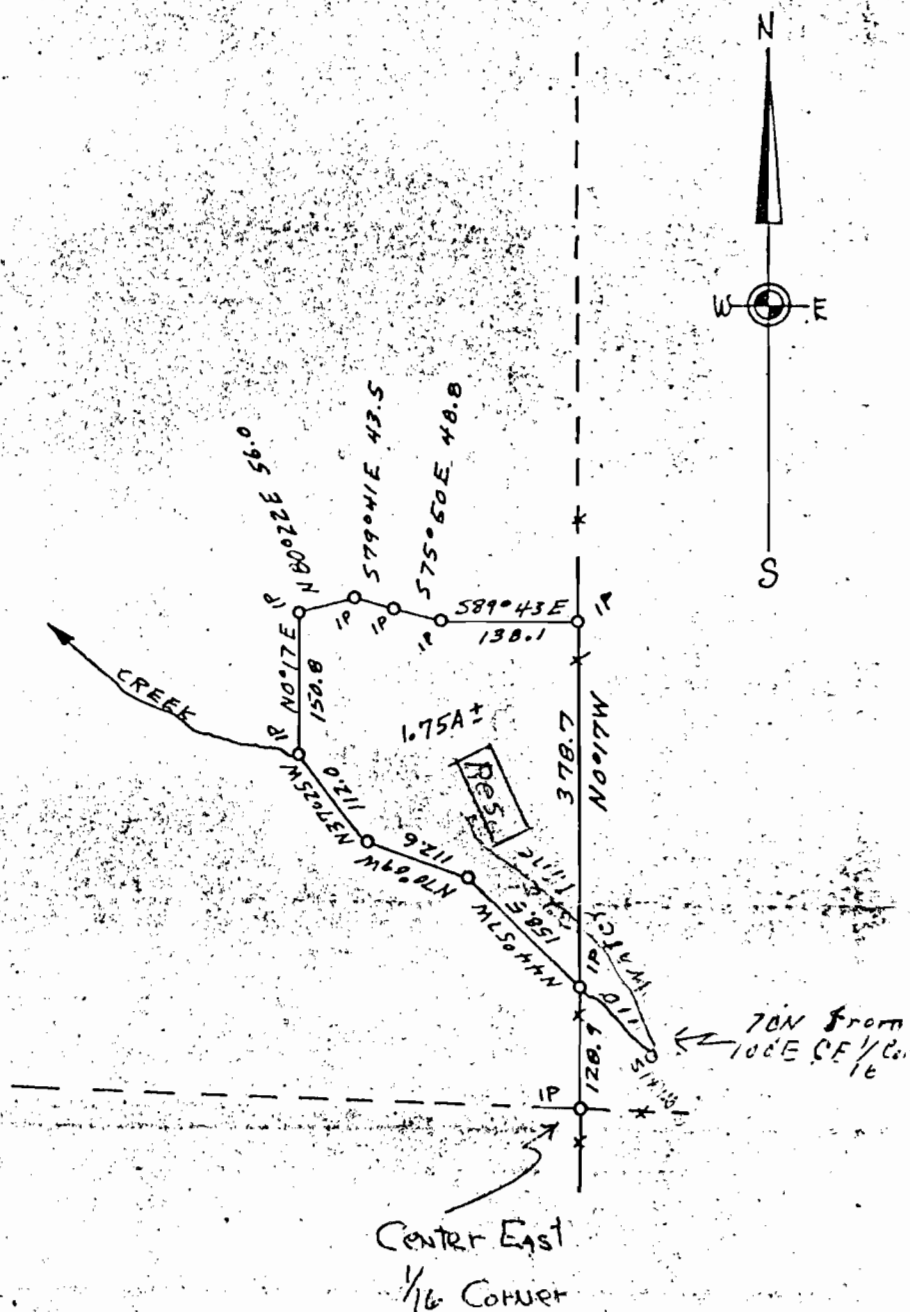

Application No. 68393

Permit No. 49412

MAP FOR DON BARRINGTON
SHOWING HUITT TRACT
IN SW 1/4 NE 1/4 SEC. 33, T. 35S, R. 14W.
W.M., CURRY CO., ORE.

Scale 1 in = 200 ft

May 1964

REGISTERED
OREGON
LAND SURVEYOR

H. J. Newhouse
MAY 10, 1957
H. J. NEWHOUSE
402

RECEIVED

June 1, 1964
CURRY COUNTY SURVEYOR

35-82