


# T. 2 S., R. 1 W., W.M.

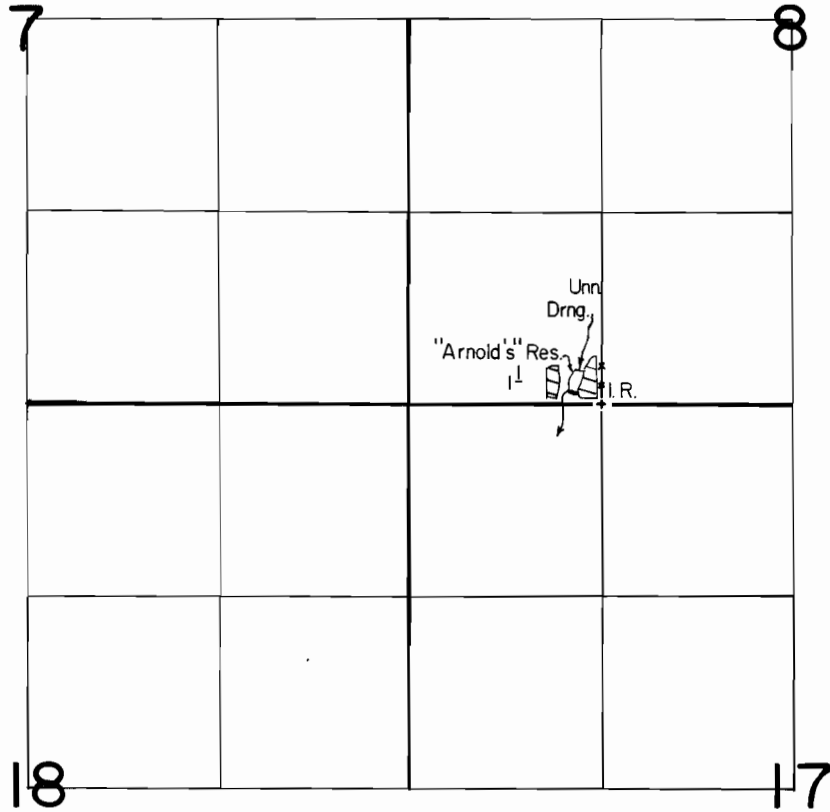

P.O.D. Loc.: 60' N. & 200' W. from SE Cor. SW<sup>4</sup>SW<sup>4</sup> Sec. 8.

Scale : 1" = 1320'

## FINAL PROOF SURVEY UNDER

Application No. ~~68583~~ R-68582 Permit No. ~~49558~~ R-10588

IN NAME OF

ARNOLD DURAZO

Surveyed JULY 11, 1988, by RUSS KLASSEN

PTS w/ FF.  
11/25/88 TW