


T. 2 S., R. 1 W., W.M.

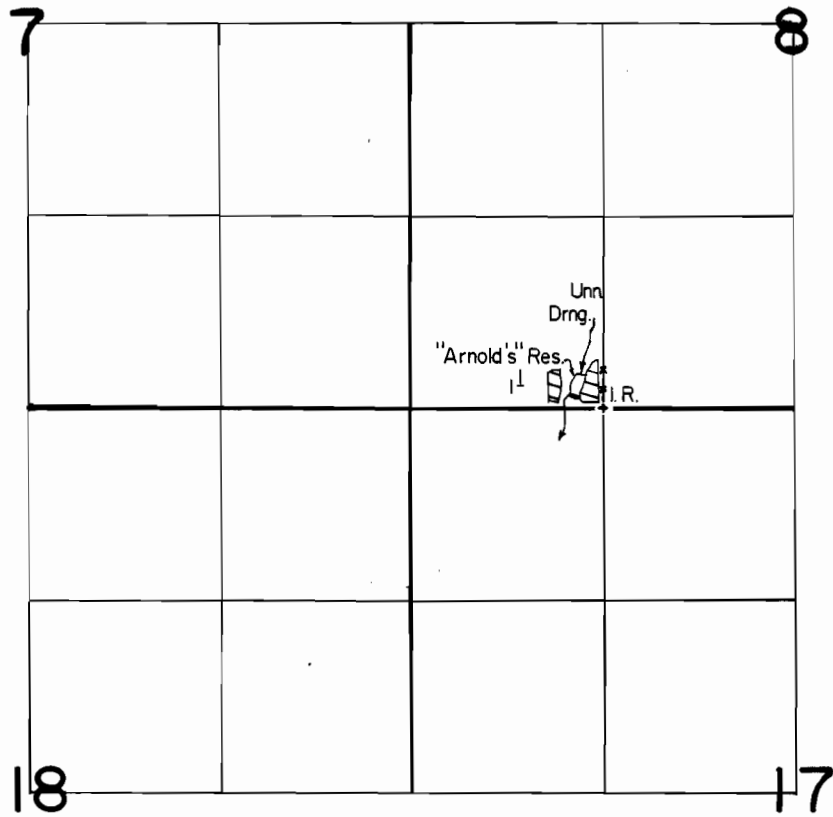

P.O.D. Loc.: 60' N. & 200' W. from SE Cor. SW⁴SW⁴ Sec. 8.

Scale : 1" = 1320'

FINAL PROOF SURVEY
UNDER

Application No. R-68582 68583 Permit No. R-10588 49558

IN NAME OF

ARNOLD DURAZO

Surveyed JULY 11, 1988, by RUSS KLASSEN

PTS w/ FF.
11/25/88 TW