


T.2 S., R.2 W., W.M.

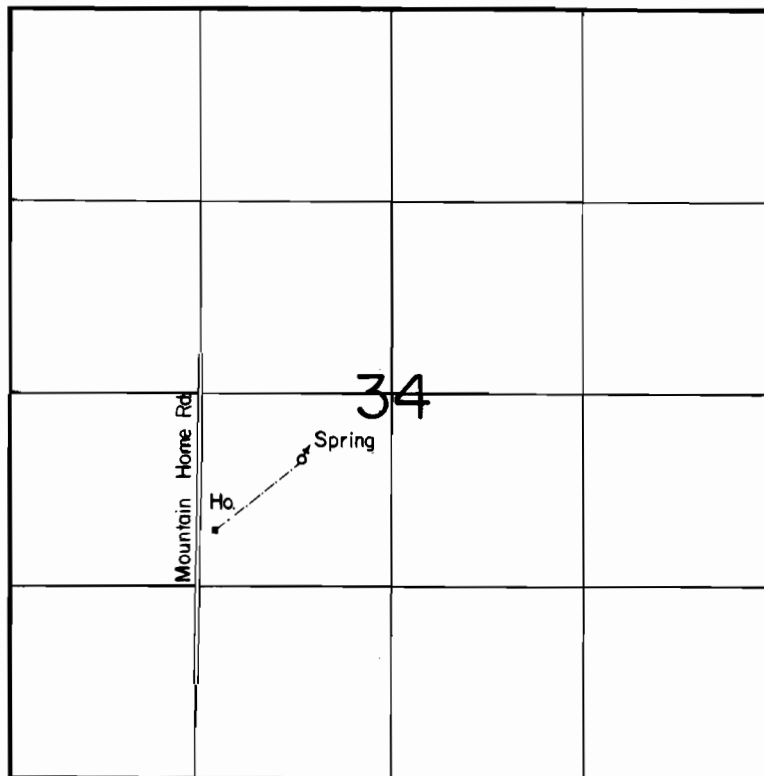

Spring Loc. : 860' N. & 700' E. from SW Cor. NE⁴ SW⁴ Sec. 34.

Scale : 1" = 1320'

FINAL PROOF SURVEY UNDER

Application No. 68691... Permit No. 49665...
IN NAME OF

MARJORIE LEKAS

Surveyed AUG 4... 1988, by T. Warren.....