
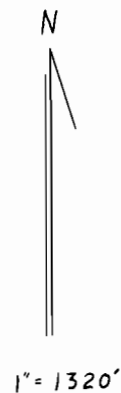


T8S, R5W, WM

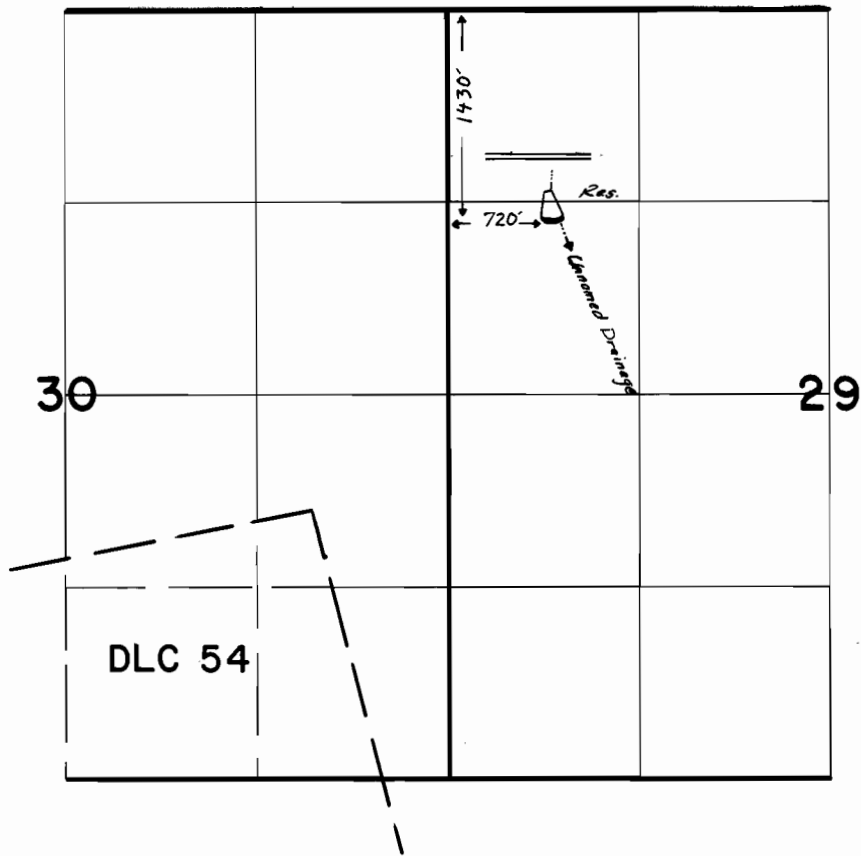

FINAL PROOF SURVEY UNDER

Application No. R-68771 Permit No. R-10738.....
IN NAME OF

.....JAMES R. MARR.....

Surveyed APRIL 7.. 1988., by T.M. WARREN.....