

RECEIVED

DEC 20 1986

JOHN P. PRAHAR  
LAND PLANNING AND SURVEYING  
(503) 347-9517

WATER RESOURCES DEPT.  
SALEM, OREGON

Fern Park Bldg. Suite 1 • 1045 Baltimore Ave.


Rt. 1 Box 620 • Bandon, Oregon 97411

RECEIVED

MAR 17 1987

WATER RESOURCES DEPT.  
SALEM, OREGON

Application No. 68775  
Permit No. 49999

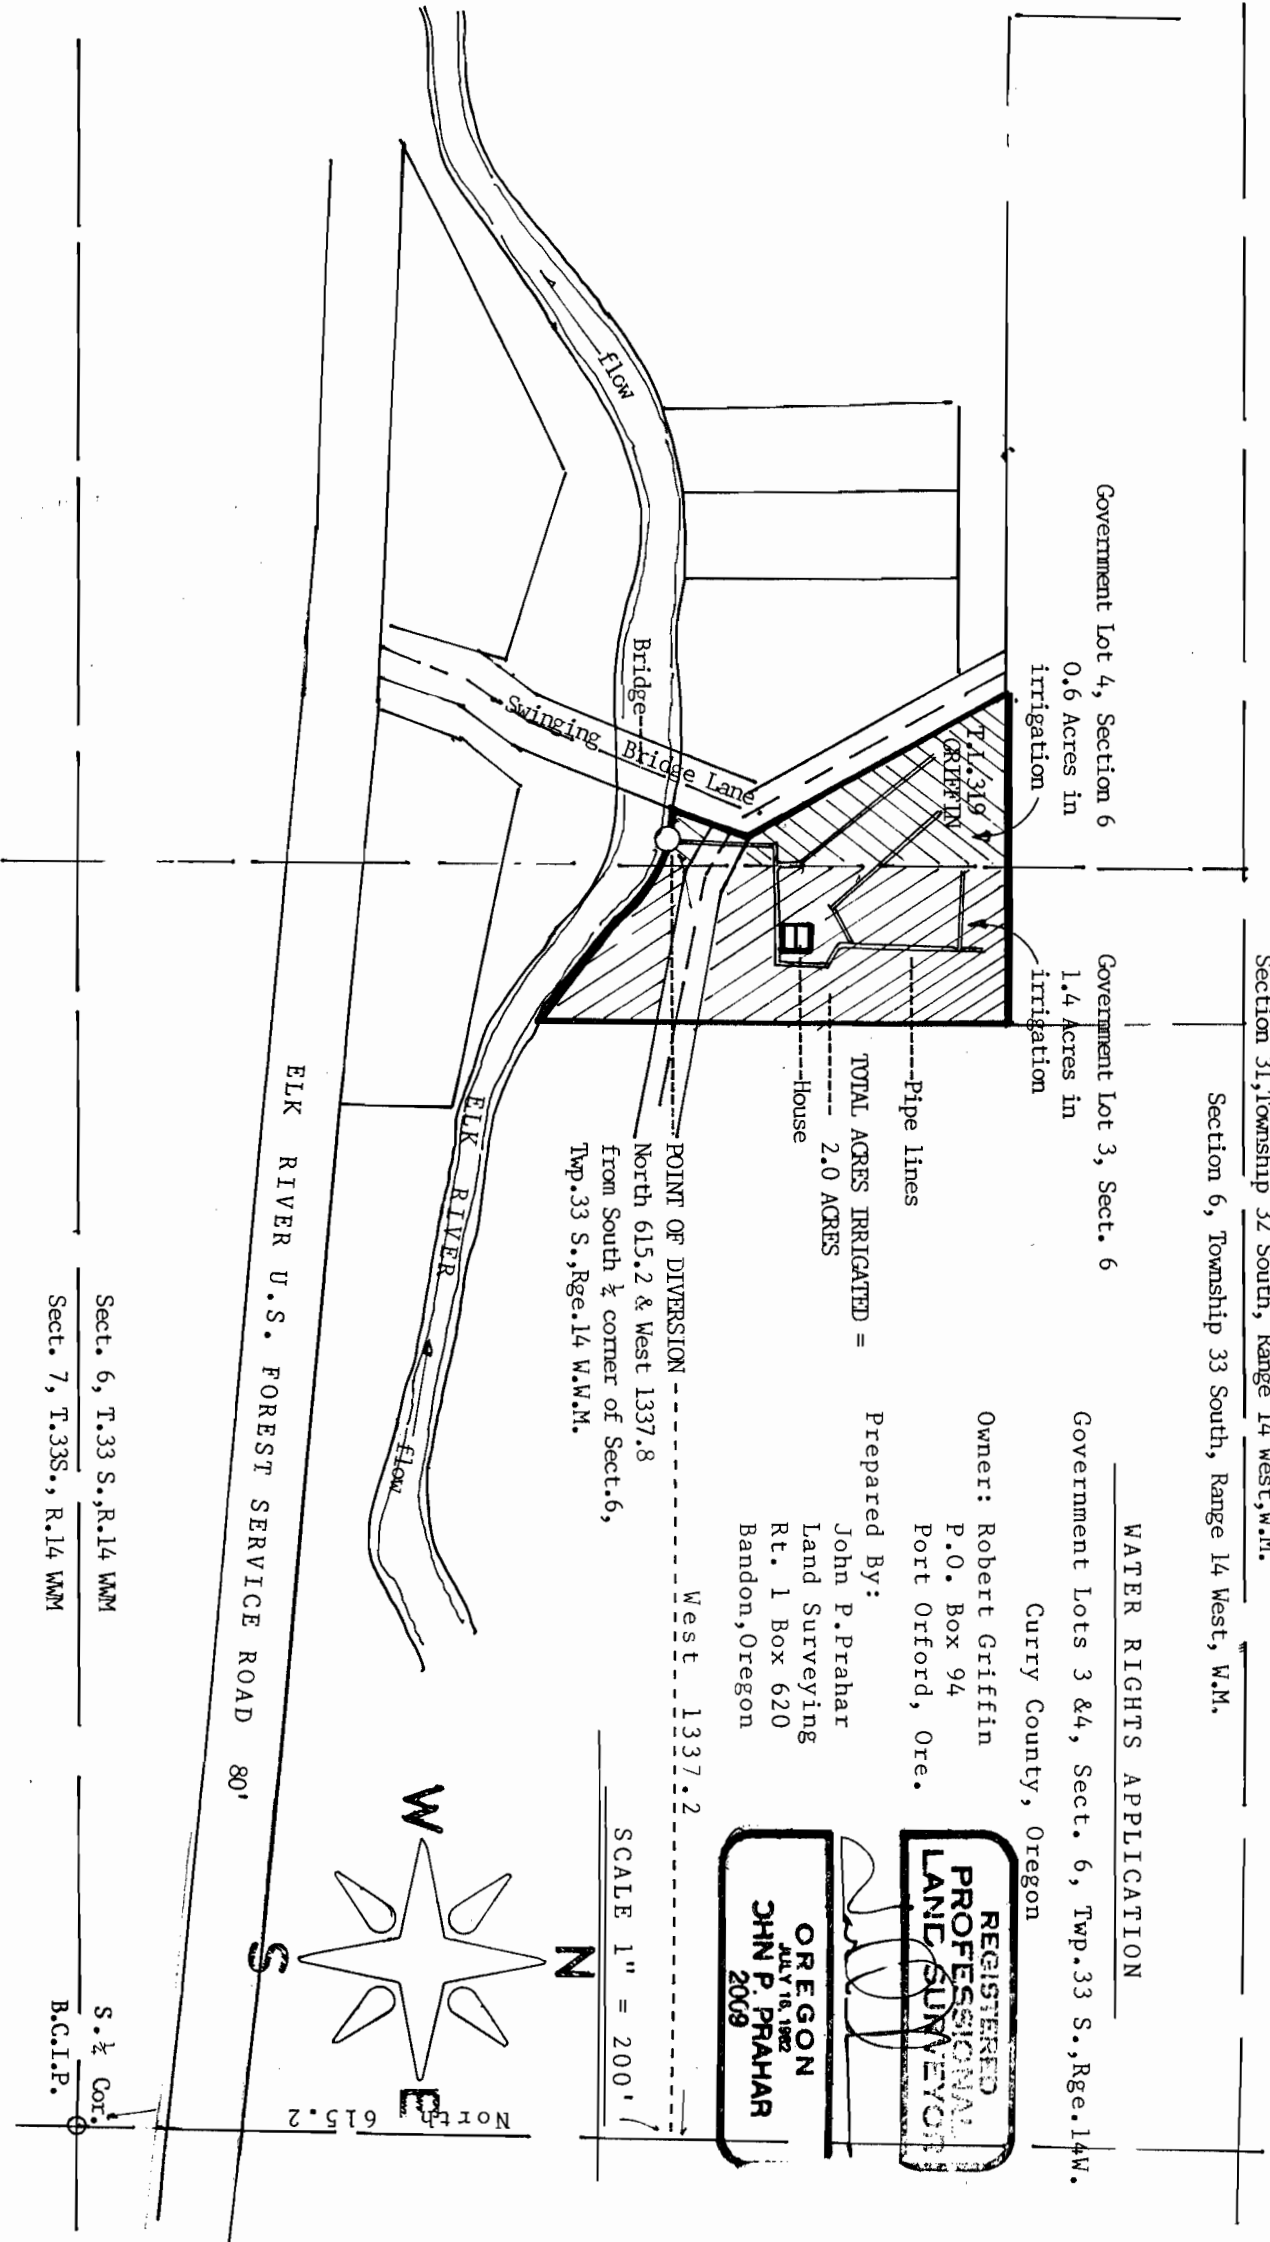

Section 31, Township 32 South, Range 14 West, W.M.

Section 6, Township 33 South, Range 14 West, W.M.

Government Lot 4, Section 6  
0.6 Acres in  
irrigation

Government Lot 3, Sect. 6  
1.4 Acres in  
irrigation

Government Lots 3 & 4, Sect. 6, Twp. 33 S., Rge. 14 W.

Curry County, Oregon

WATER RIGHTS APPLICATION

Owner: Robert Griffin  
P.O. Box 94  
Port Orford, Ore.

Prepared By:

John P. Prahara  
Land Surveying  
Rt. 1 Box 620  
Bandon, Oregon

TOTAL ACRES IRRIGATED =  
2.0 ACRES

Pipe lines

House

West 1337.2

SCALE 1" = 200'


POINT OF DIVERSION  
North 615.2 & West 1337.8  
from South 1/4 corner of Sect. 6,  
Twp. 33 S., Rge. 14 W.M.M.

ELK RIVER U.S. FOREST SERVICE ROAD 80'

ELK RIVER

Sect. 6, T.33 S., R.14 W.M

Sect. 7, T.33S., R.14 W.M

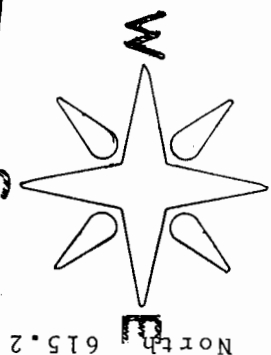

S. 1/4 Cor.

B.C.I.P.