


T. 4N., R. 2W., W.M.

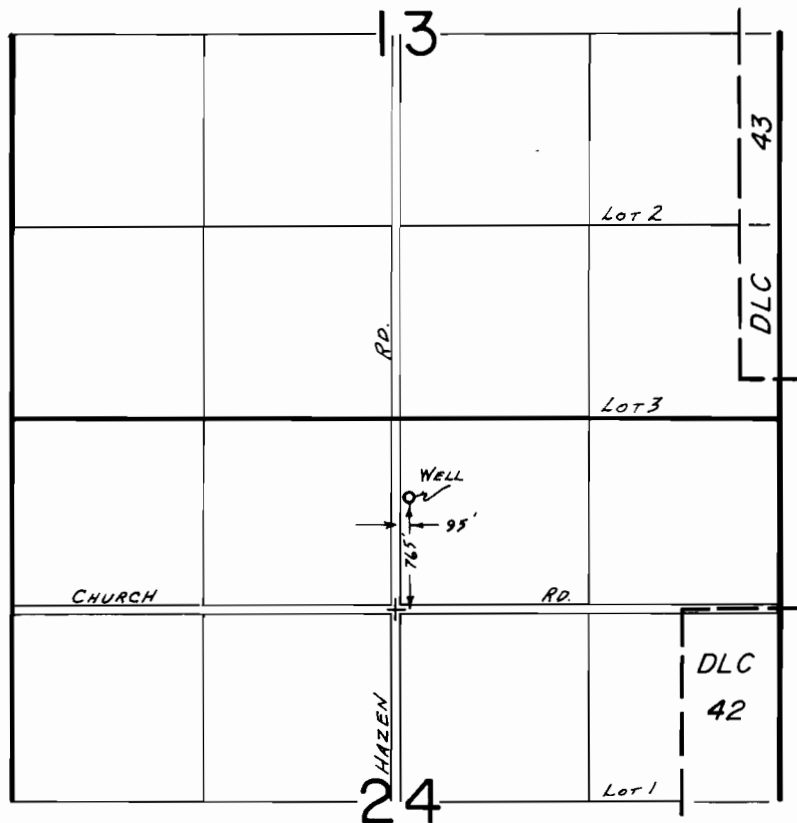

WELL LOCATION ONLY

FINAL PROOF SURVEY
UNDER

Application No. G-4692 Permit No. G-8028.....
IN NAME OF

.....WARREN WATER ASSOCIATION.....

Surveyed MAY 8..... 19.80., by R.G. MUCKEN.....