


T. 38 S., R. 1 W., W. M.

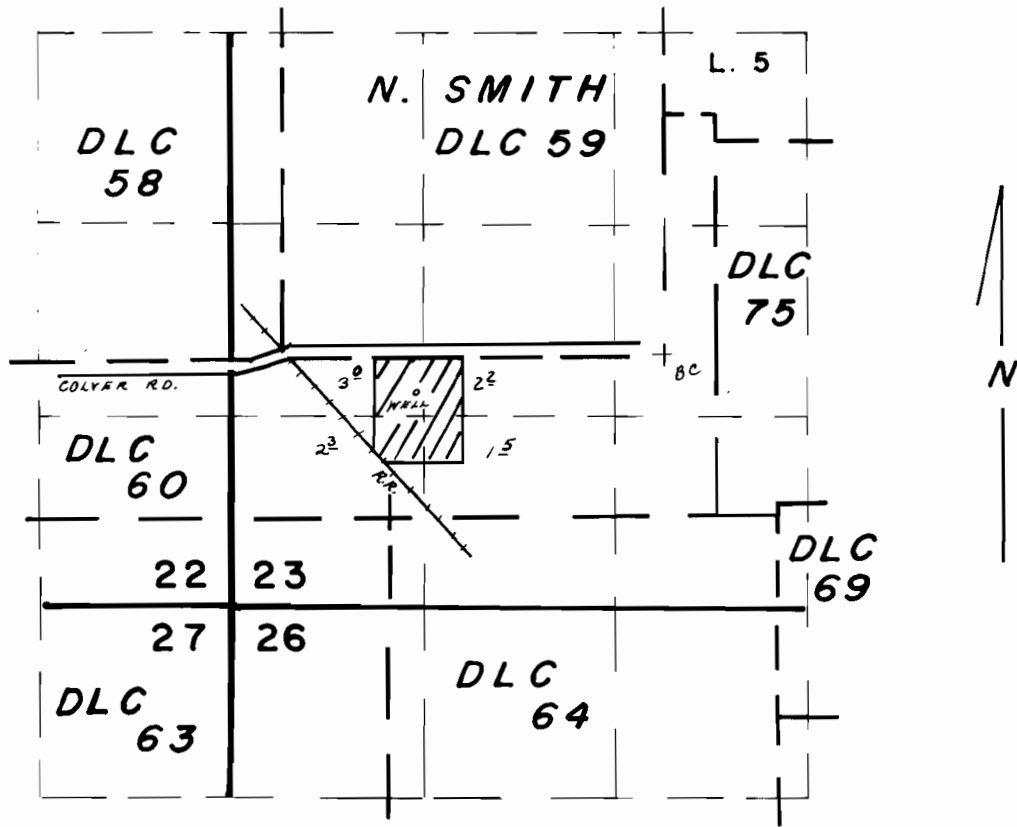

WELL LOCATION: 260' S. & 1720' W. FROM S.E. COR. OF DLC 59

SCALE: 4" = 1 MILE

FINAL PROOF SURVEY
UNDER

Application No. G-6554 Permit No. G-6158...
IN NAME OF

.....*RICHARD A. JAMES*.....

Surveyed MAY 23 1985, by B.S. JAMES.