


# T. 11 & 12 S., R. 4 W., W.M.

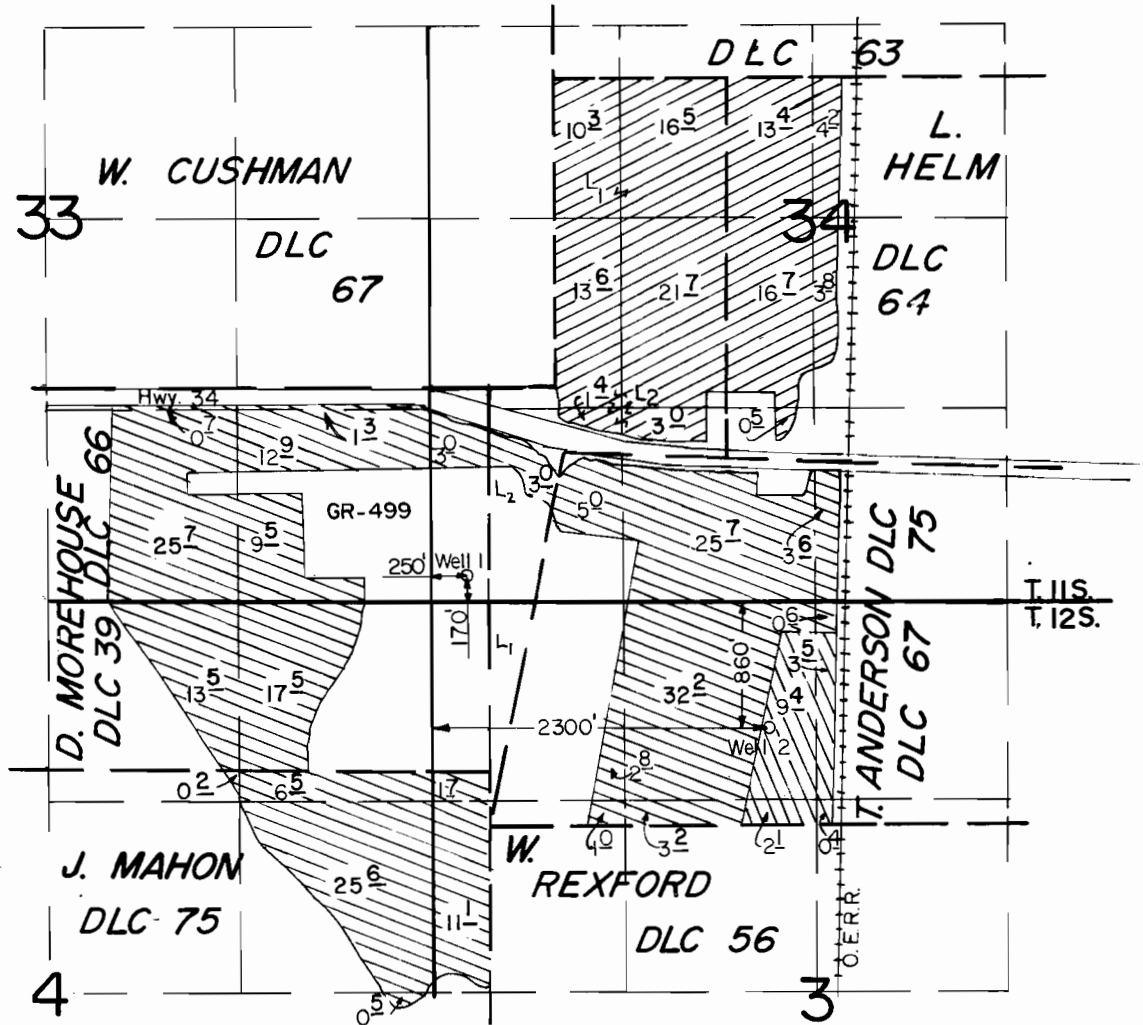

Scale: 1" = 1320'

## FINAL PROOF SURVEY UNDER

G-7434

G-6931

G-7714

G-8137

Application No. G-9439. Permit No. G-8858...

IN NAME OF

# STEVE & VIRGINIA GLASER

Surveyed Oct. 10, 1985, by T. WARREN



Zoom TRANSFER