90684

T. 11 & 12 S., R. 4 W., W.M.

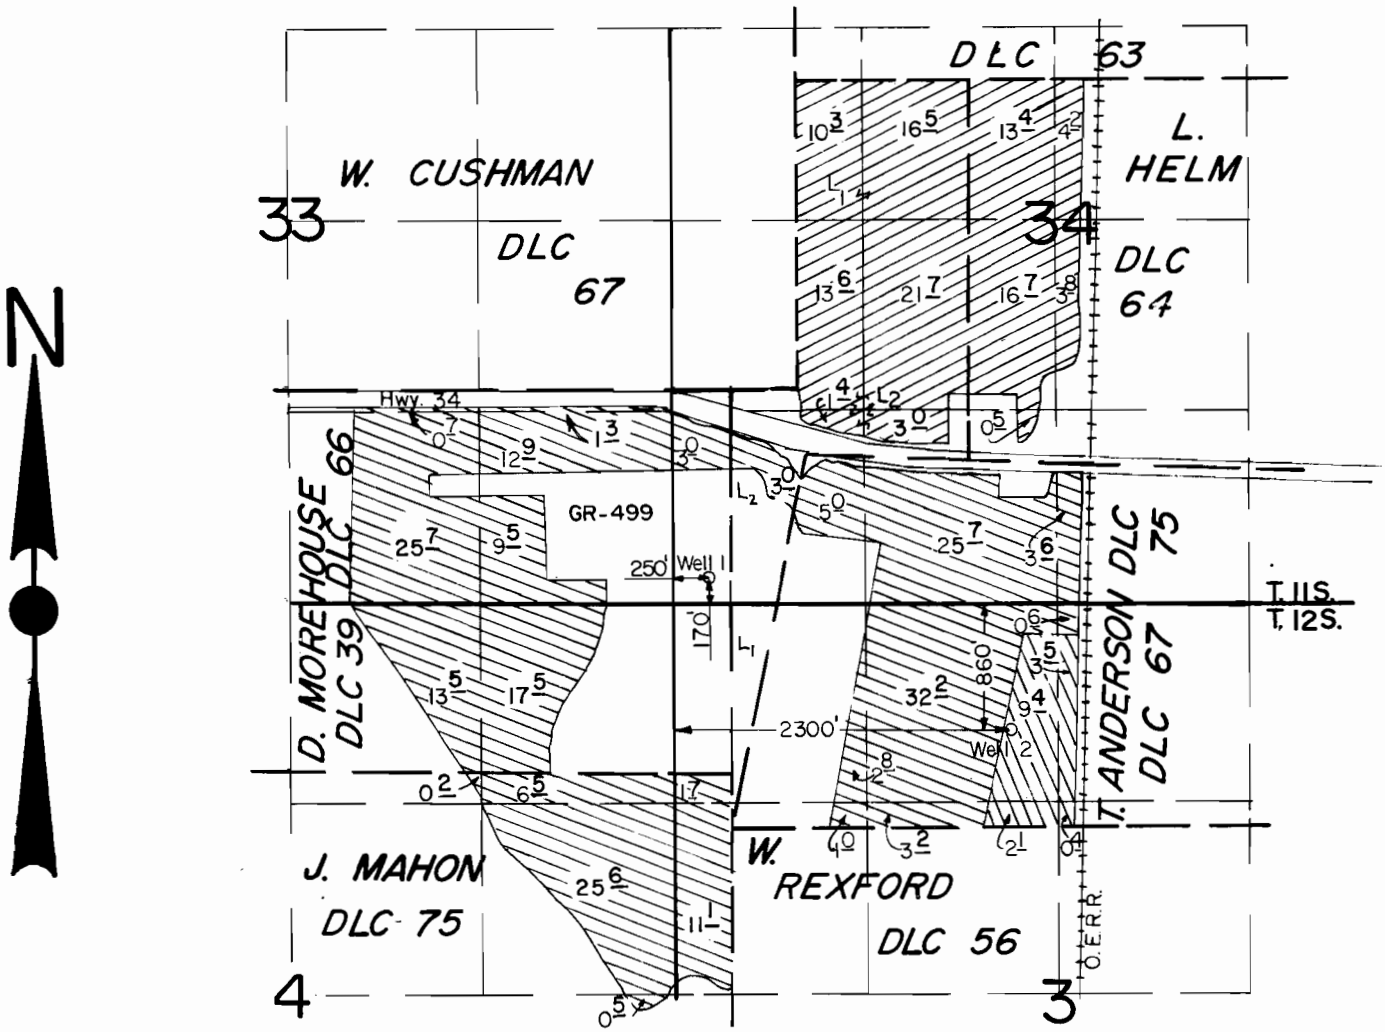

Scale: 1" = 1320'

FINAL PROOF SURVEY

UNDER

G-7434 G-6931
G-7714 G-8137
Application No. G-9439 Permit No. G-8858

IN NAME OF

STEVE & VIRGINIA GLASER

Surveyed Oct. 10 1985, by T. WARREN

Zoom Transfer
X 41043-178-148 D 2-mw

REVISED 7/6/87 LHN