


# T. 38 S., R. 3 W., W.M.

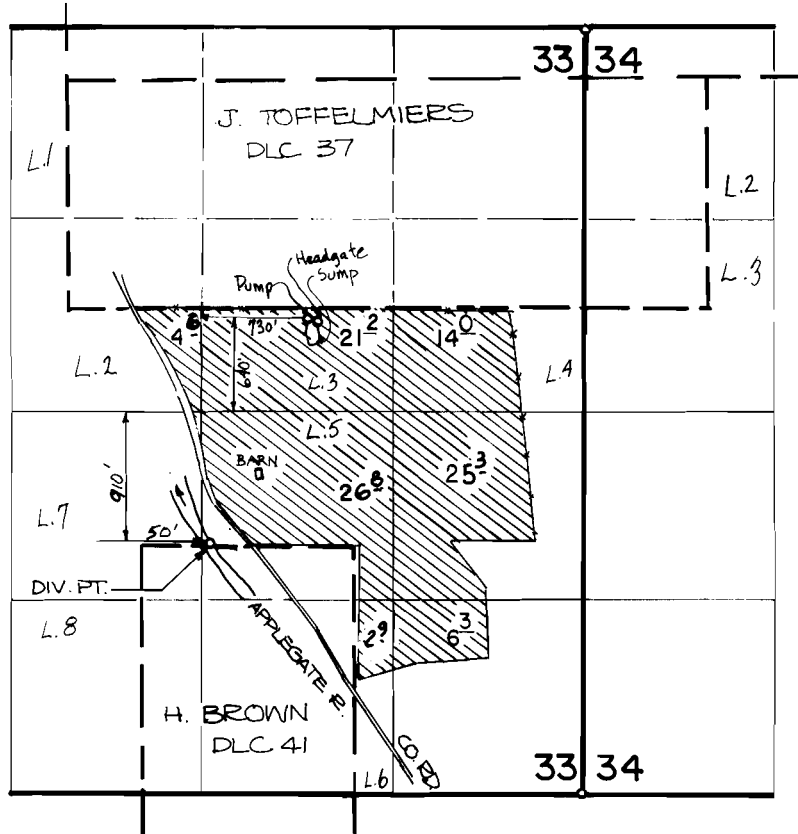

## FINAL PROOF SURVEY UNDER

Application No. ~~G 8636~~ 62251 ..... Permit No. ~~G 8003~~ 45539 .....  
 IN NAME OF

**ELDA CRANE & WAYNE A. & LINDA HEALY**

Surveyed MAY 18, 1983, by B. S. JAMES