


T. 5 S., R. 4 W. WM

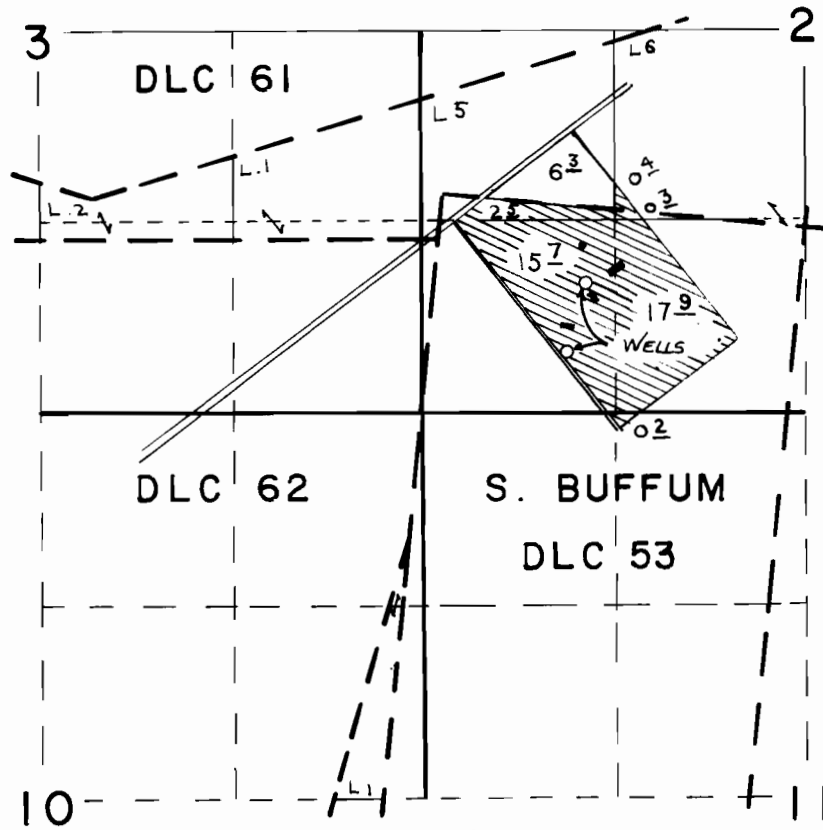

DIV. PT. LOC. 410' N. & 990' E. OF SW COR. SEC. 2
 300' N. & 120' E. OF S/W COR. SEC. 2

FINAL PROOF SURVEY UNDER

Application No. G. 8784 Permit No. G. 8086
 IN NAME OF

ROBERT FRASER

Surveyed APR. 23. 1984, by P. PASTER