


T. 24S., R. 32 1/2E., W.M.

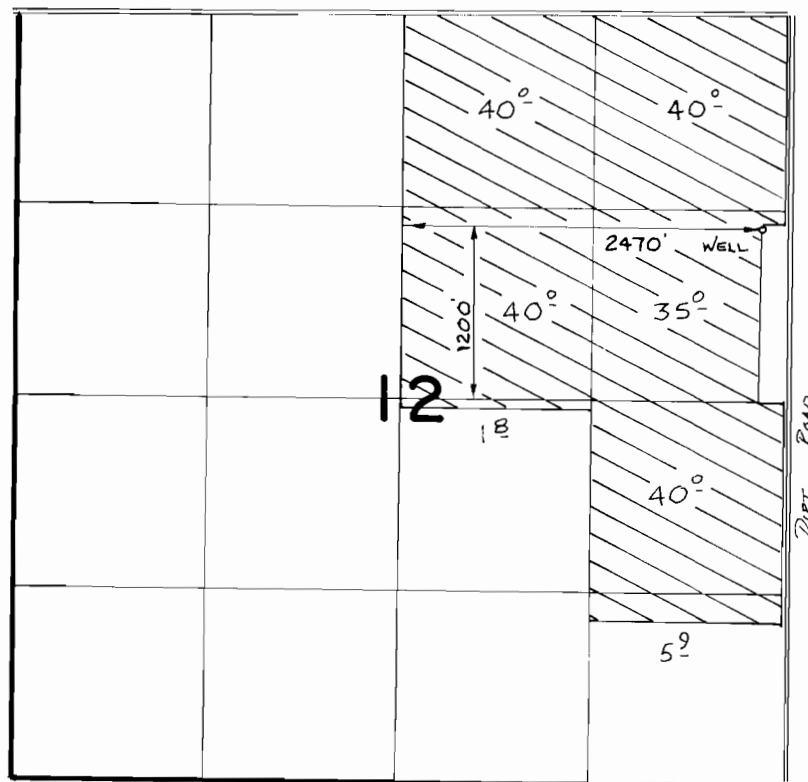

Scale 1" = 1320'

FINAL PROOF SURVEY

UNDER

Application No. **G:8800** Permit No. **G:8241**....
IN NAME OF

PHILLIP M. & FLORENCE ANDEREGG

Surveyed 5-6 1988, by V.L. Church