


T.9S., R.39E., W.M.

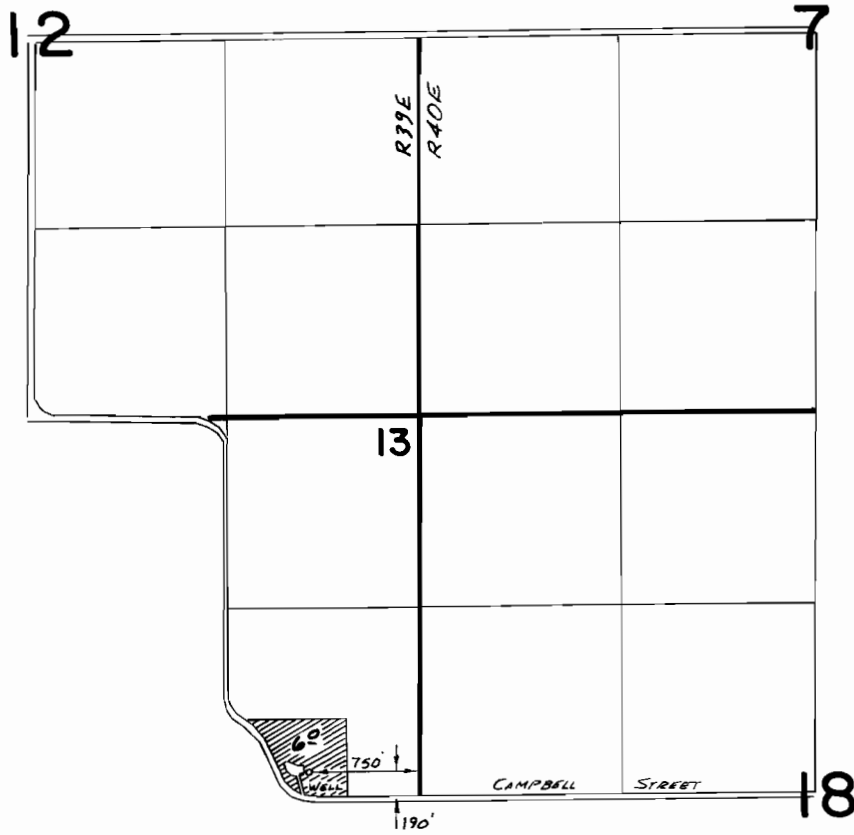

**FINAL PROOF SURVEY**  
UNDER

Application No. **G:8952** Permit No. **G:8508**..  
IN NAME OF

.....**GERALD D. DELFATTI**.....

Surveyed *APRIL 13* 19*82*., by *V.R. Church*.....