


*T.37S., R.5W., W.M.*

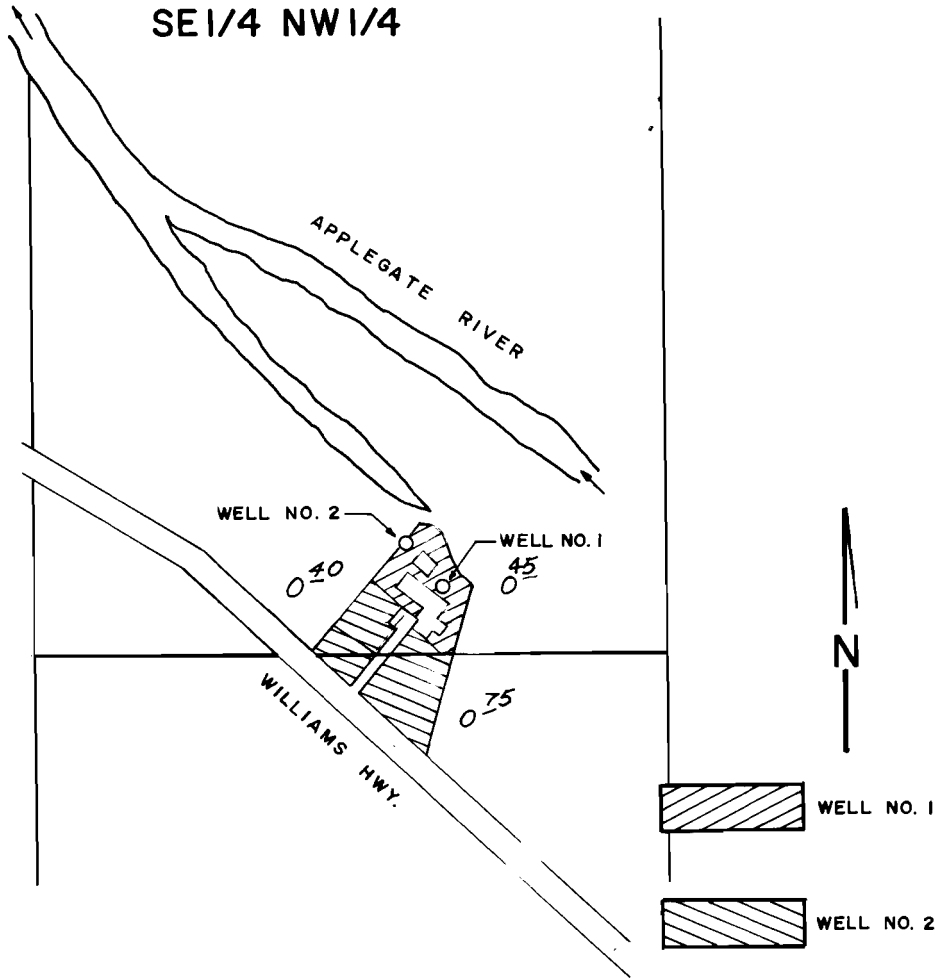

NE1/4 SW1/4

WELL NO. 1 LOC: 2610'S. & 2155'E.; WELL NO. 2 LOC:  
2510'S. & 2090'E.; BOTH FROM THE N.W. COR. OF SEC. 35

(SECTION 35)

*1" = 400'*

**FINAL PROOF SURVEY**

UNDER

Application No. G-9127 Permit No. G-8514

IN NAME OF

**JACK & LYNN OLDHAM**

Surveyed JUNE 16, 1982 By B. SUND