


T. 39 & 40 S., R. 7 W., W. M.

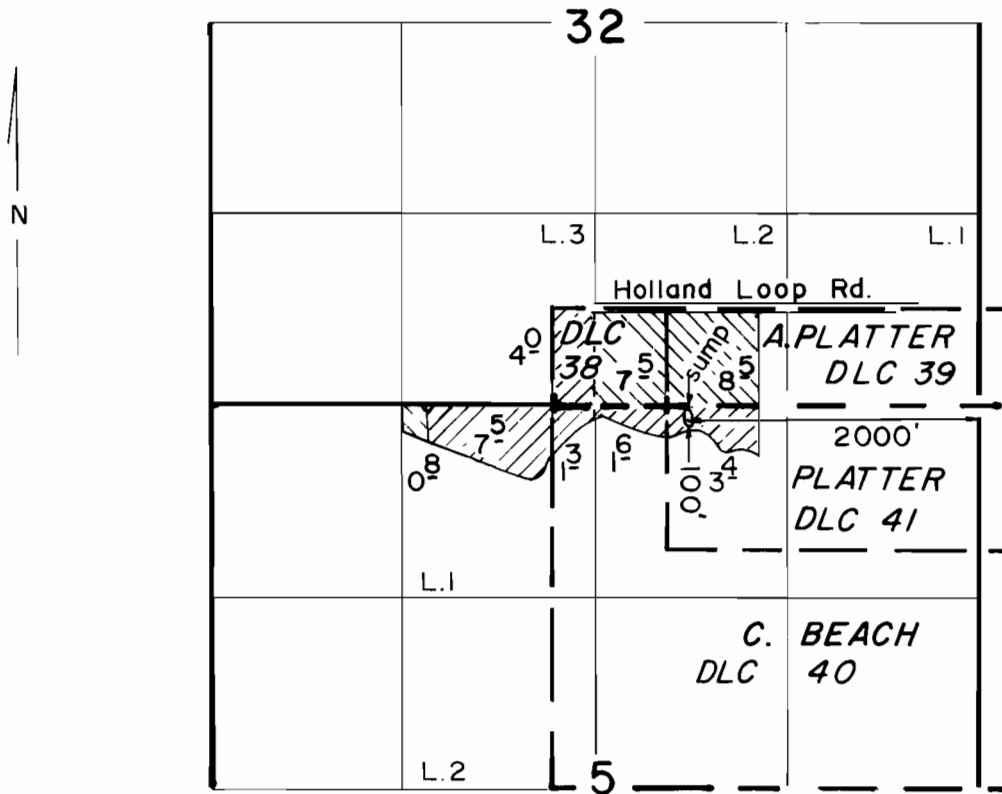

Scale: 1" = 1320



Primary



Supplemental

**FINAL PROOF SURVEY**  
UNDER

Application No. G-9165 Permit No. G-8577  
IN NAME OF

DEAN MAYFIELD

Surveyed MAY 12 1986, by B. S. JAMES