


T.7S.,R.2W.,W.M.

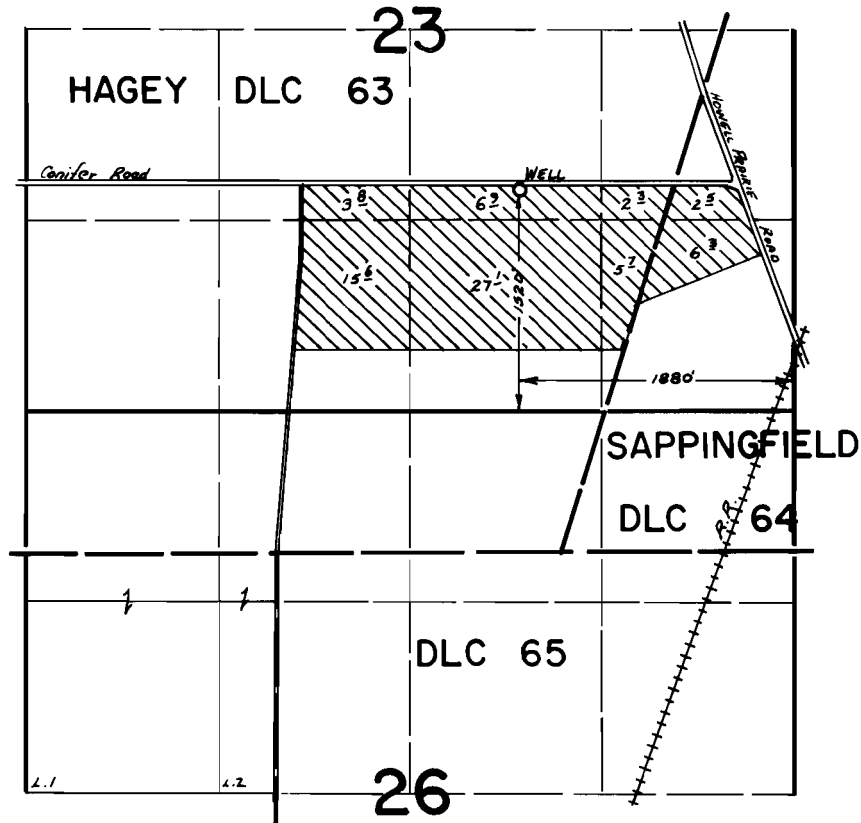

FINAL PROOF SURVEY
UNDER

Application No. G-9166. Permit No. G-8519.....
IN NAME OF

JAMES E. FRAZIER

Surveyed Oct. 29... 1981., by S.C. BROWN.....