


T. 25S., R. 31E., W. M.

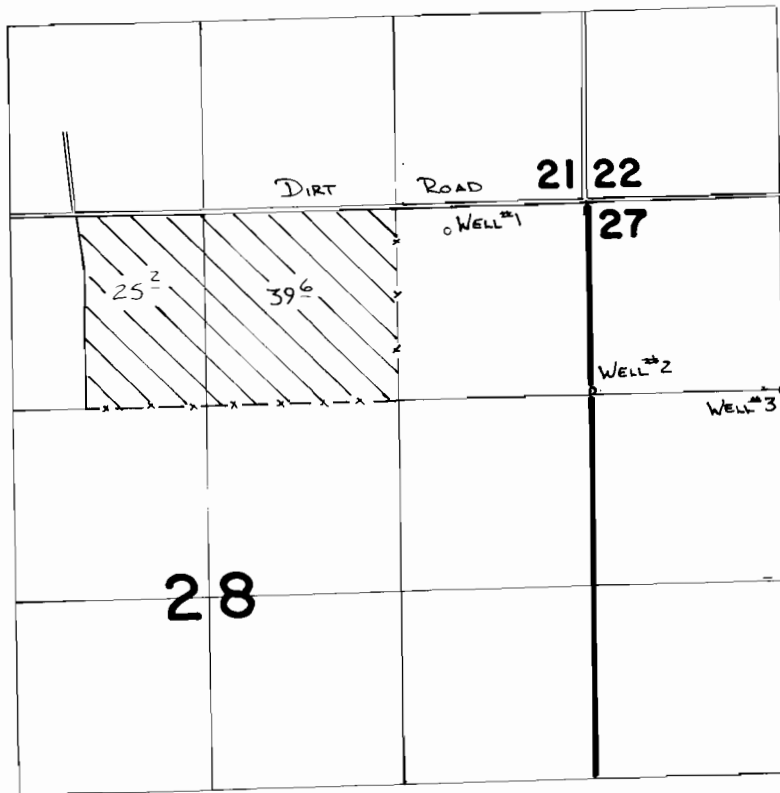

Scale 1" = 1320'

WELL #1 Loc: 160'S. & 970'W. }
 WELL #2 Loc: 1300'S. & 10'E. } From NE COR. Sec. 28
 WELL #3 Loc: 1330'S. & 1320'E. }

FINAL PROOF SURVEY
UNDER

Application No. **G:9195** Permit No. **G:8550**
IN NAME OF

DONOVON F. & BARBARA A. WOHLERS

Surveyed 5-9 1988, by T.M. WARREN