


T.10S.,R.3W.,W.M.

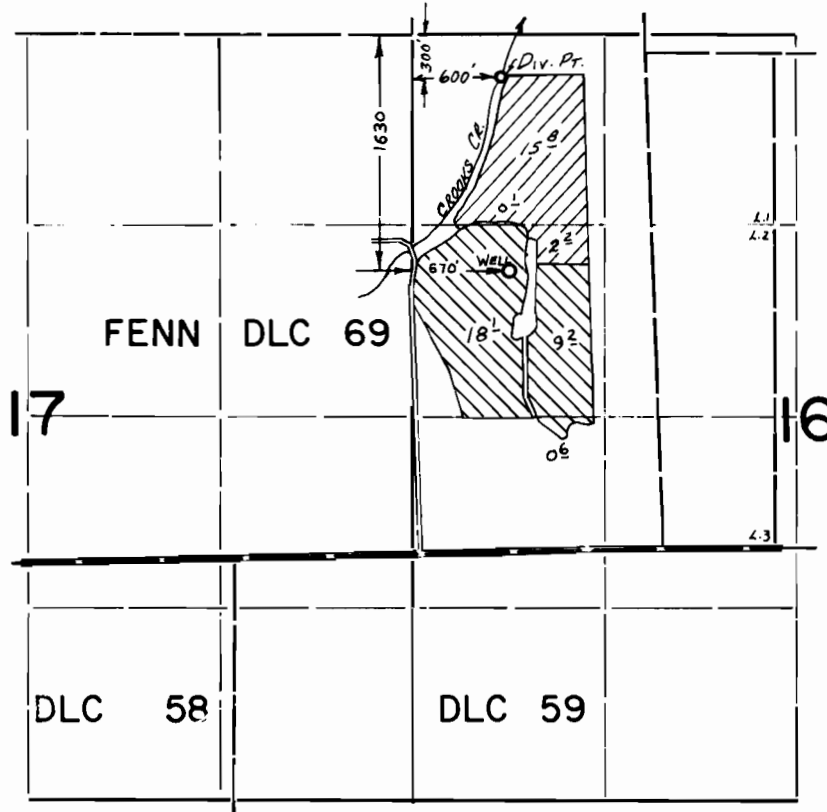

**FINAL PROOF SURVEY**  
UNDER

58575                      44098      
Application No. G:9211.. Permit No. G:8667.... 

IN NAME OF

.....IVAN MUSTOE.....

Surveyed July 28, 1982, by L.M.TOLL.....  
June 7 1983