


T.10S.,R.3W.,W.M.

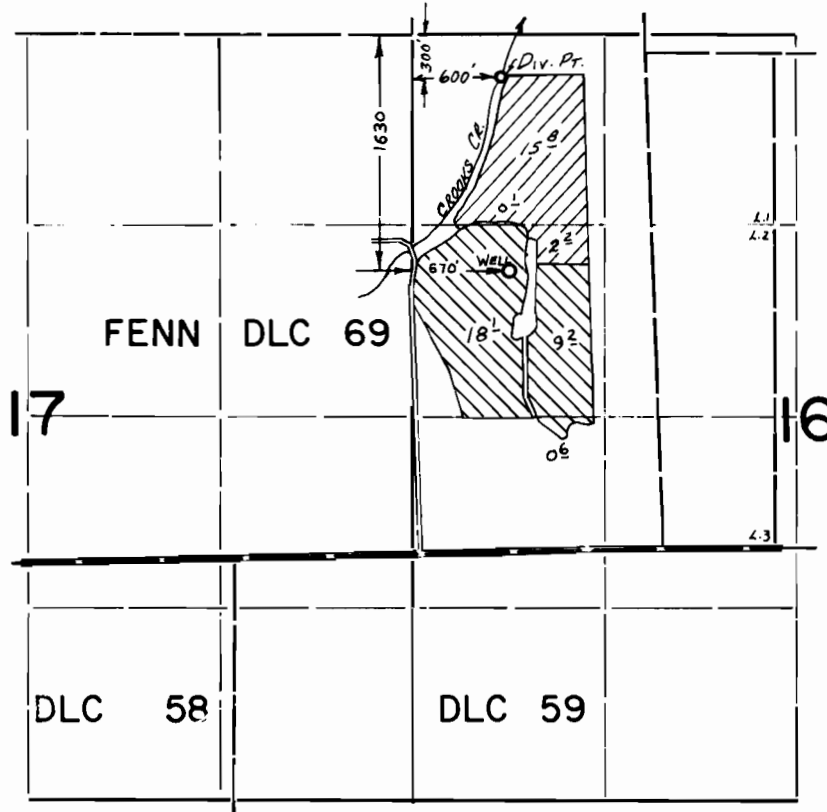

FINAL PROOF SURVEY
UNDER

58575 44098 
Application No. G:9211.. Permit No. G:8667.... 

IN NAME OF

.....IVAN MUSTOE.....

Surveyed July 28, 1982, by L.M.TOLL.....
June 7 1983