


# T.16S.,R.3W.,W.M.

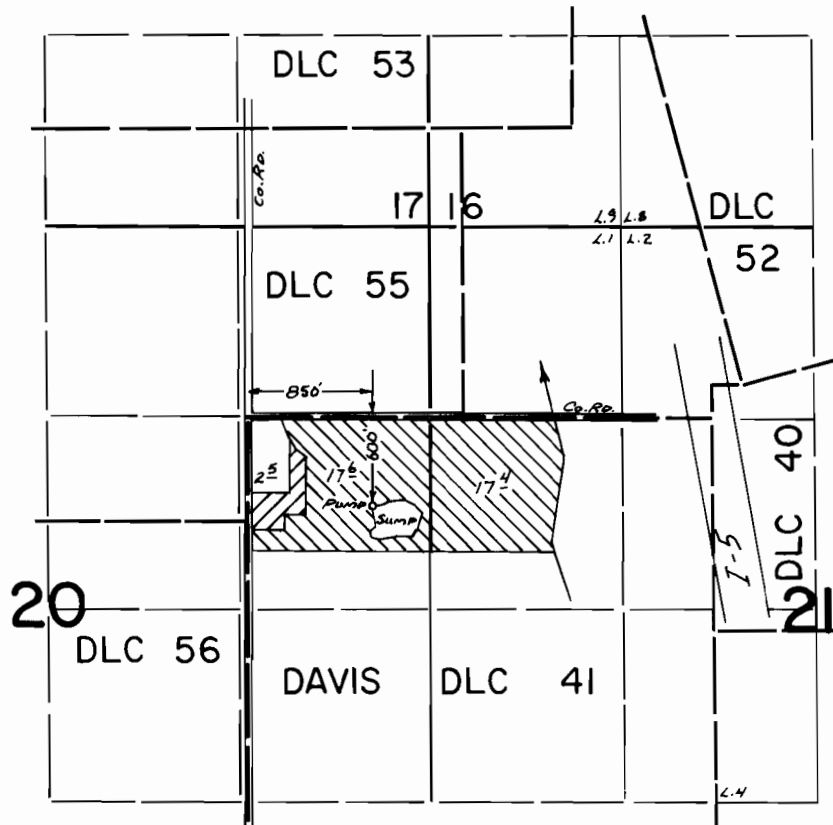

## FINAL PROOF SURVEY UNDER

Application No. G:92.17.. Permit No. G:8582.....

IN NAME OF

CHARLES W. SWANGO

Surveyed June...15.. 19.82., by L.M.TOLL.....



PRIMARY

SUPPLEMENTAL