


T. 1 S., R. 45 E., W. M.

SCALE: 1" = 1320'

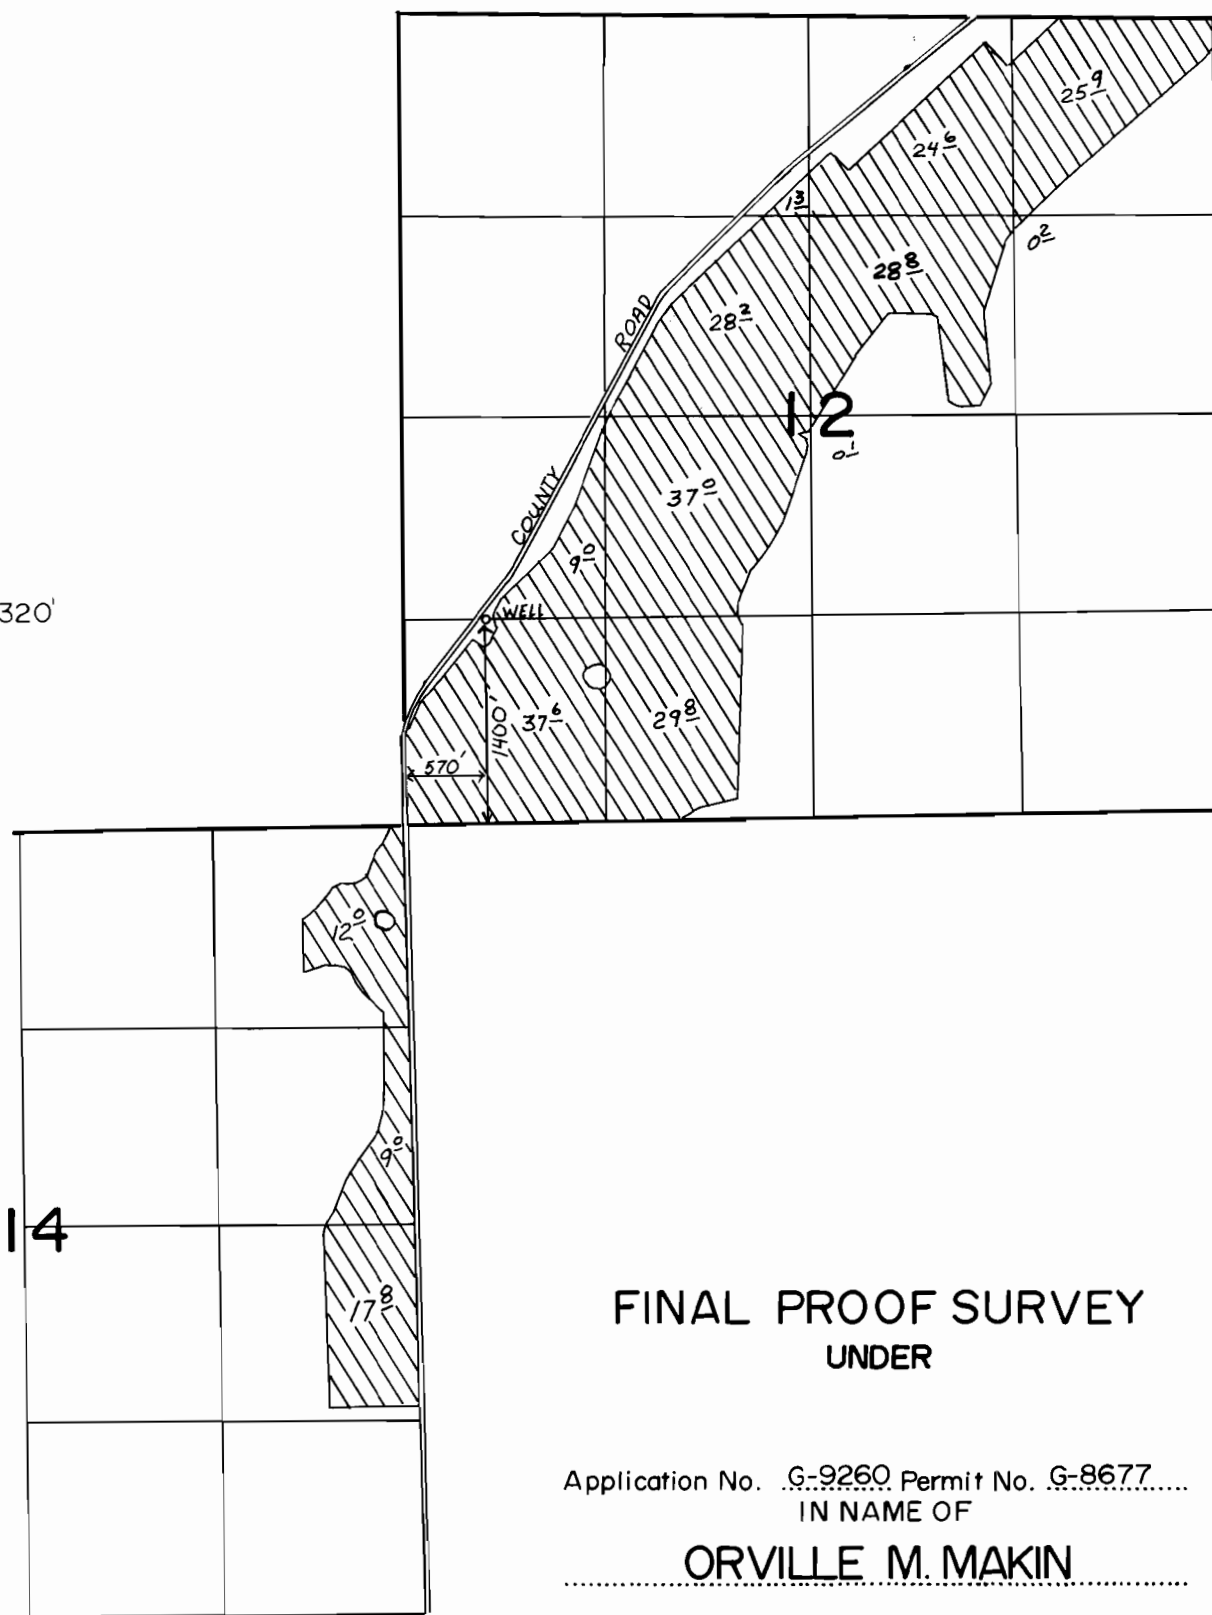

FINAL PROOF SURVEY
UNDER

Application No. G-9260 Permit No. G-8677
IN NAME OF

ORVILLE M. MAKIN

Surveyed Aug. 6, 1985, by V. L. CHURCH