


T.10S.,R.2W.,W.M.

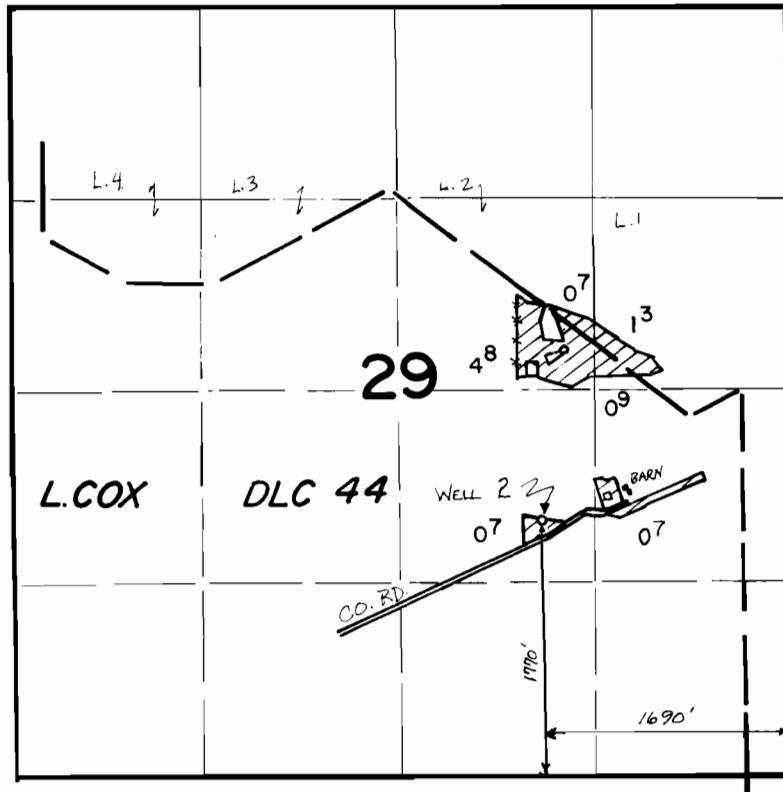

FINAL PROOF SURVEY UNDER

Application No. G.9264 Permit No. G.8687.....
IN NAME OF

BLAND K. & RUTH M. SHEFFIELD

Surveyed OCT. 20, 1983., by M. CAHILL.....