


98630

60720

T.5N., R.28E., W.M.

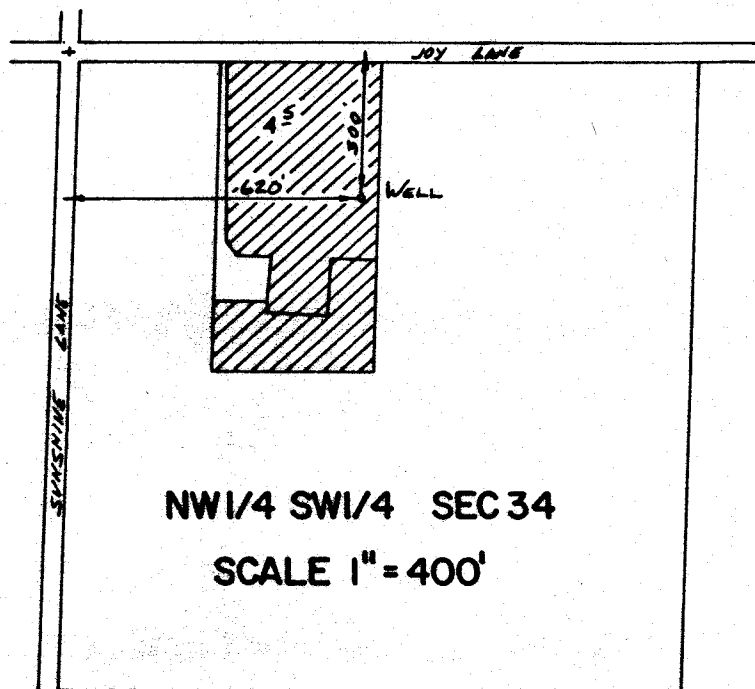

FINAL PROOF SURVEY
UNDER

Application No. **G-9280** Permit No. **G-8630**
IN NAME OF

KEITH D. & RACHEL S. SMITH

Surveyed **3-24** 19**83**, by *J.H. Church*