


# T.16S.,R.3W.,W.M.

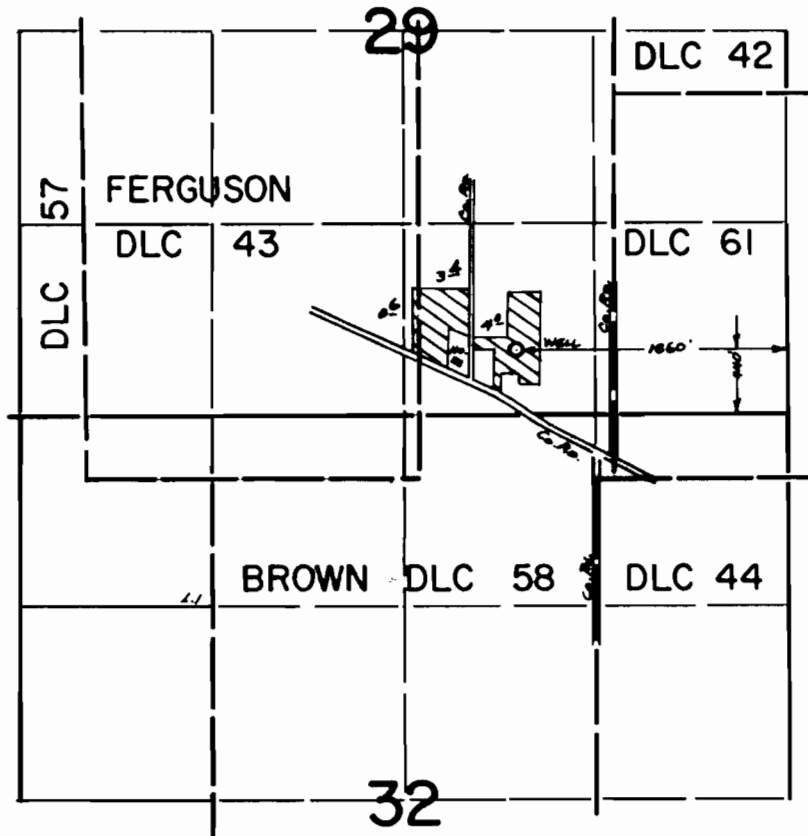

## FINAL PROOF SURVEY UNDER

Application No. G:9304. Permit No. G:8616.....  
IN NAME OF

.....JOHN B. LEARY.....

Surveyed July..14... 1982., by .L.M.TOLL.....