T. 6S., R. 2W., W.M.

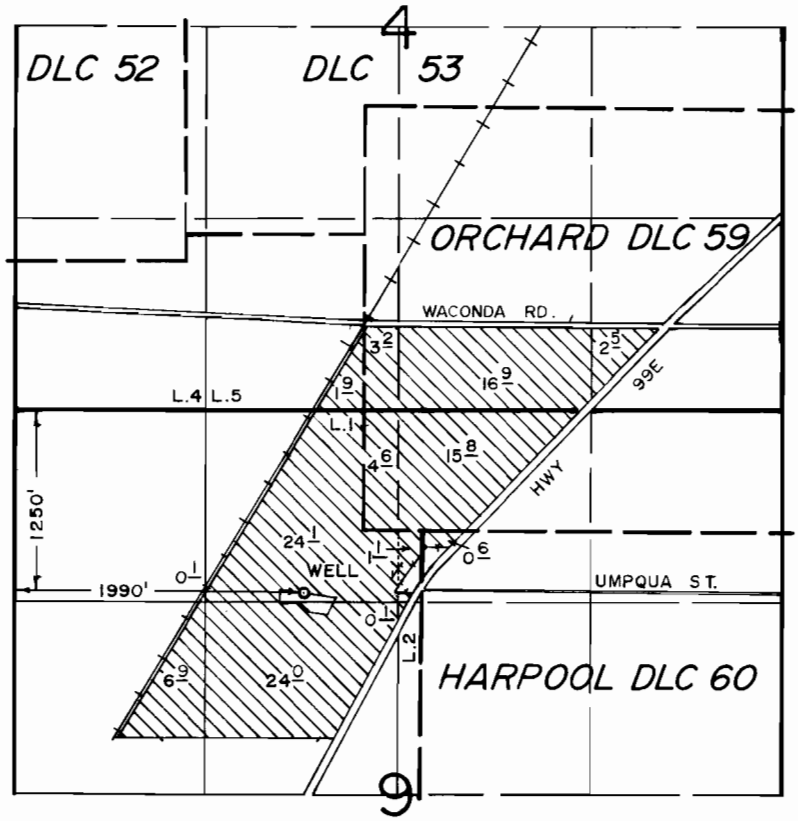

FINAL PROOF SURVEY
UNDER

Application No. G-9357 Permit No. G-8635
IN NAME OF

PAUL N. KUDERER

Surveyed MAY 12 19 80, by B.W. BISHOP

DFN-SLL-263
PTS 1980-J