


# T. 17 S., R. 5 W., WM

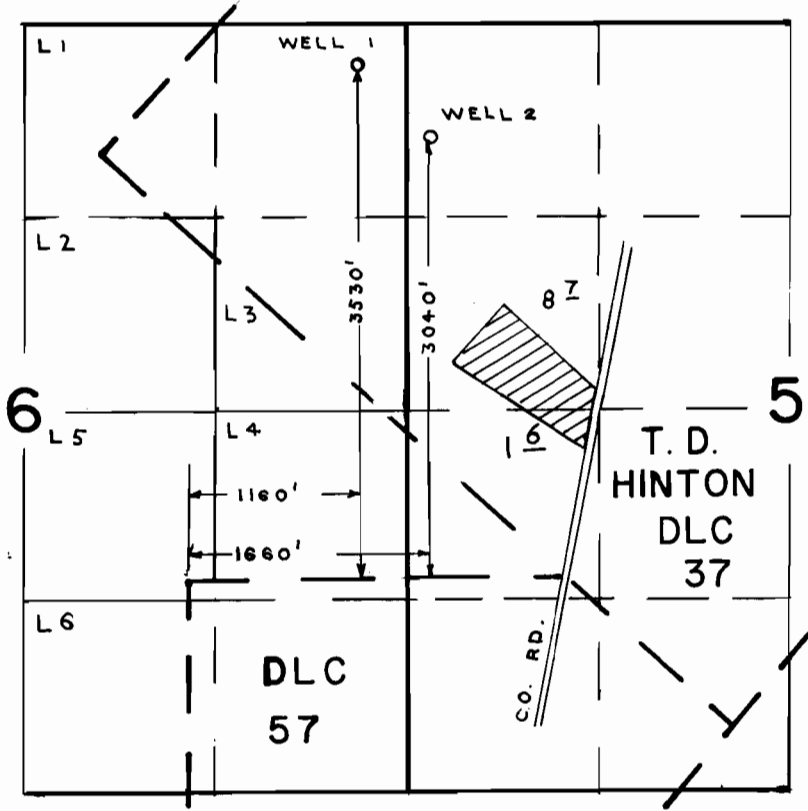

## FINAL PROOF SURVEY UNDER

Application No. G. 9392 Permit No. G. 8750  
IN NAME OF

J. A. BUSH

Surveyed MAY 8, 1984, by P. PAGTER