


T.4&5S., R.1W., W.M.

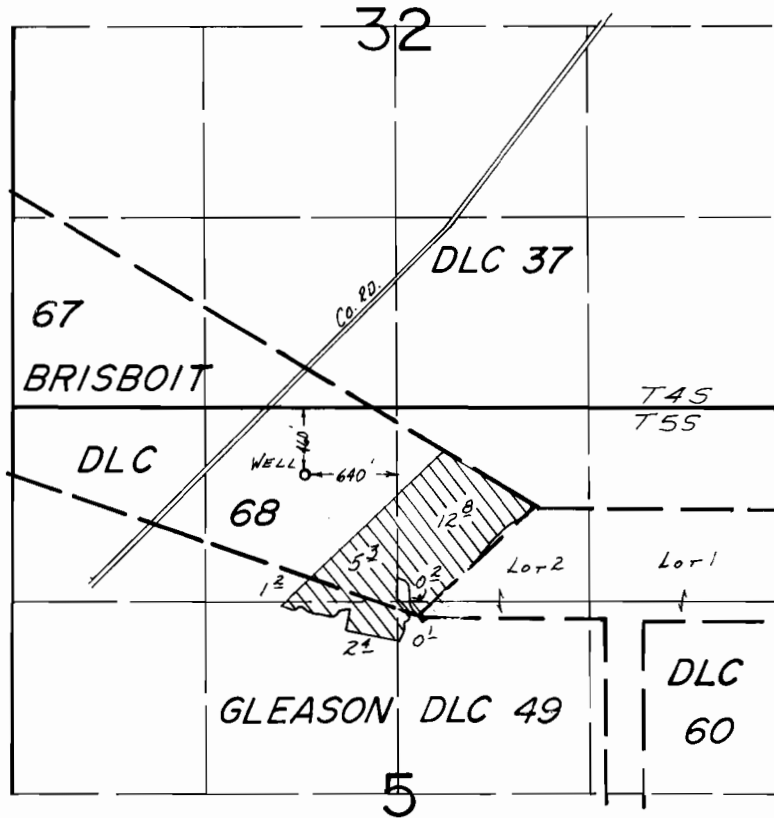

SCALE: 1"=1320'

FINAL PROOF SURVEY UNDER

Application No. G-9437... Permit No. G-8669.....
IN NAME OF

JAY G. NELSON.....

Surveyed April 19, 1984, by B.W. BISHOP.....